80 SECTION

# DE ADAMS COUNTY COUNTY CORNER NO: 36 RANGE ADAMS COUNTY CORNER NO: 41906082000


## PUBLIC LAND SURVEY MONUMENT RECORD

**HARRISON** TYPE OF MONUMENT: ADAMS COUNTY COORDINATES, NAD 83 (2007) N. **279689.146** E. 536132.604 DATUM 12/03/2018 FIELD WORK DATE:

#### **BASIS FOR MONUMENT LOCATION**

1980 - PLS 1478 FOUND A 1" IRON PIPE PER SURVEY BY R. K. SAYLER, FOR ADOLF PAVELEC DATED DEC. 13, 1974. THIS SURVEY IS LOCATED IN THE SE1/4 OF SECTION 8-19-6 AND IS ON FILE IN THE ADAMS COUNTY SURVEYOR'S OFFICE. NO OTHER EVIDENCE OF MONUMENTATION WAS FOUND. EXISTING 1" IRON PIPE TO BE REPLACED BY A HARRISON MONUMENT IN THE SPRING OF 1980.

2018 - PLS 2675 FOUND A HARRISON MONUMENT 6" ABOVE THE GROUND SURFACE AND 2 WITNESS TREES. THE MONUMENT AGREES WITH THE EXISTING WITNESS TREES, ACCEPTED THE HARRISON MONUMENT AS THE CORNER LOCATION, SET 4 NEW TIES AND MEASURED TO THE TIES AND WITNESS TREES.

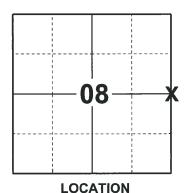

(INDICATE CORNER BY "X")



DATA SHOWN HERE ON THIS TIE SHEET IS CORRECT AND COMPLETE TO THE BEST OF MY KNOWLEDGE AND BELIEF.

PROFESSIONAL LAND SURVEYOR

1-18-19

#### -TIE SKETCH




SET 3/4" x 18" IRON REBAR, 1.50#/FT

**FOUND HARRISON MONUMENT** 

VINYL "T" POST

WITNESS TREE

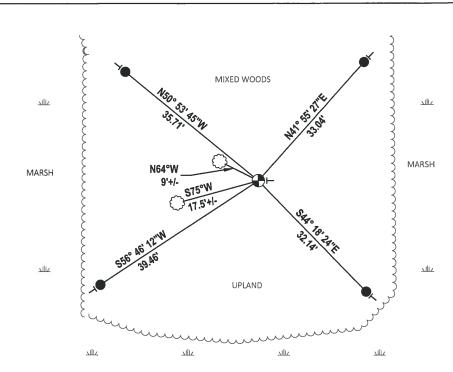

<b>Government Land Corner Certificate</b>		
2	CORNER NO.	36
HOAMS County Existing 1" Iron Pipe to be replace	d have SECTION	8
Harrison Monument Spring 1980	TOWN	
STATE PLANE COORDINATES: N	RANGE	6
ELEVATION — M.S.L. DATUM:		
THETA ANGLE:		
FIELD BOOK: 83 PAGE 35		
DRAWN BY: G. RHINEHART	<u> </u>	<b>*</b> NI
DACKS FOR MONTH TO COMPANY		I. IN
BASIS FOR MONUMENT LOCATION		
Show info such as: History of corner, with reference to Vol. and pg., dates, surveyor; exact description of monument		
replaced; if location computed, by taped or EDM traverse; landowner remarks, etc. (Use reverse side if necessary)	LOCATION (Indicated by 'X')	
Found 1" iron pipe per survey by R. K. Sayler,	SEAL:	
for Adolf Pavelec dated Dec. 13, 1974.	All Halles	
This survey is located in the $SE_{4}^{\frac{1}{4}}$ of Section 8-19-6 and is on file in the Adams County Surveyor's Office.	GREGORY P. RHINEHART S-1478 Wisconsin Rapids Wis.  DATA SHOWN HERE ON CERTIFIED CORRECT:  Registered Land Surveyor  DATE:	140
No other evidence of monumentation was found.	State A.	l'E
THE OWNER GUEROLIOS OF MONIGOROUS HAD TOMICS	GREGORY P.	\ <u>\$</u>
	S-1478 Wisconsin Parti	
	Wis. Napids	!
	The state of the s	<b>₹.3</b>
	NO SURVE	ara ara
	DATA SHOWN HERE ON	
	CERTIFIED CORRECT:	•
	Registered I and Surveyor	hard
	DATE:	<b>3</b> 0
	DATE:	
TIE SKETCH 2		com
Show at least four ties, also fence lines, roads, topo, size and type of witness trees' and if off road - best way to		50' ±
arrive at corner.	0 EAST (2-1-8	(8)
ESTIMATED	14"	,(
HOD' EAST OF	&" BLACK	OAK,
	(a)	BT
4"BLACE		\
OAK '08 '	90 SAST DINE	_ ;; /
NAKOL	190 JEAST PINE 10" JACK FACE DND FENCE (.	5 WEST
ANCIENT,	OND FENCE (.	DOGUN)
10" A" BLACK 73.02"	0 - 70'±	
JOAK, - (8) 17.8 0	70'\$	
NEW WAIL	3" BLACK	BT S
1.08		, (' <sub>&gt;</sub>
	7	
".		
NEW NAIL OF OAK!	, (	` /
NATIC OS CATO	1	

### MAINTENANCE RECORD

DATE	BY WHOM	REMARKS
4-24-83	6R- 55	0, K.
Z-l-88	GR-55	OK
1-6-93	IG-135	Ok .
2-24-98	JG-55	ok .
Nov '08	575	3 NEW TIES