07 SECTION

ADAMS COUNTY COUNTY COUNTY CORNER NO: 42 ROMPORTOL ID: 41906070020


PUBLIC LAND SURVEY MONUMENT RECORD

HARRISON TYPE OF MONUMENT: ADAMS COUNTY COORDINATES, NAD 83 (2007) N. **276970.506** E. 528209.156 **ELEVATION-**DATUM 12/03/2018 FIELD WORK DATE:


BASIS FOR MONUMENT LOCATION

1976 - PLS 1103 RAN EDM/TRANSIT TRAVERSE AROUND SECTION 7 AND THE ADJACENT SECTIONS TO DETERMINE THE SEARCH AREA FOR INVESTIGATION. EXCAVATION WITH A BACKHOE YIELDED NO EVIDENCE OF THE ORIGINAL CORNER OR ANY REMONUMENTATION. FOUND NO RECORD OF THE 1" IRON PIPE ON THE SOUTH SIDE OF BIG HORN AVENUE, BEING ON THE QUARTER LINE. CALCULATED THE CORNER LOCATION ON LINE BETWEEN THE ADJACENT SECTION CORNERS AND PROPORTIONAL TO THE ORIGINAL NOTES. SET A HARRISON MONUMENT AT THE CALCULATED LOCATION AND TIED OUT.

2018 - PLS 2675 FOUND A HARRISON MONUMENT 10" BELOW THE ROAD SURFACE, 2 TIES AND 1 WITNESS. THE MONUMENT AGREES WITH THE EXISTING TIES AND WITNESS. ACCEPTED THE HARRISON MONUMENT AS THE CORNER LOCATION. SET 2 NEW TIES AND MEASURED TO THE TIES AND WITNESS.

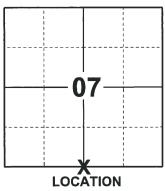

(INDICATE CORNER BY "X")

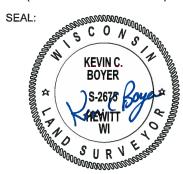


DATA SHOWN HERE ON THIS TIE SHEET IS CORRECT AND COMPLETE TO THE BEST OF MY KNOWLEDGE AND BELIEF.

PROFESSIONAL LAND SURVEYOR


-18 - 19

-TIE SKETCH

NOTE: THE CORNER FALLS 0.5'± SOUTH OF THE CENTERLINE OF BIGHORN AVE.

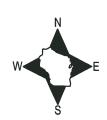

- SET 3/4" x 18" IRON REBAR, 1.50#/FT
- FOUND 3/4" IRON ROD
- FOUND 1-1/2" O.D. IRON PIPE
- FOUND HARRISON MONUMENT
- VINYL "T" POST

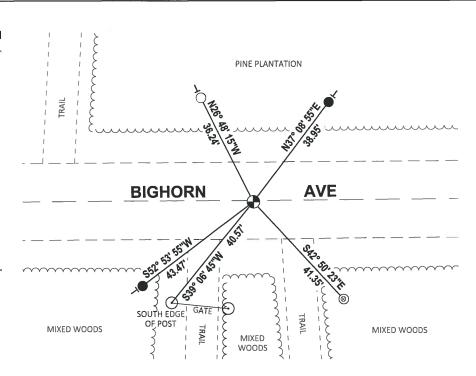

ADAMS COUNTY

Survey Monument Record

TYPE OF MONUMENT: 30" HARRISON STATE PLANE COORDINATES: N_

 \mathbf{E}_{-}

ELEVATION — M.S.L. DATUM: _

THETA ANGLE: __

BASIS FOR MONUMENT LOCATION

(Use reverse side if necessary)

Show info such as: History of corner, with reference to Vol. and pg, dates, surveyor; exact description of monument replaced; if location computed, by taped or EDM traverse; landowner

Set by retracement of a Perry-Carrington survey.

11-2778 RN-DA OK 6R-SS \mathbf{z} NEW 3-11-83 TIE S 6R-55 z-1-88 0/

1-4-93 JG-BS OK

2-11-98-56 12-30-02 -JG

TIE SKETCH OK, 2-12+08 CPR

10" NORWAY /07 (Show at least four ties)

BENCHM PRK ELEU, 9971




CORNER NO. _3/2

SECTION

TOWN

6 RANGE

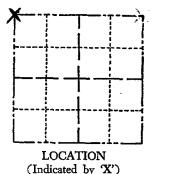

SEAL:

CERTIFIED CORRECT:

Registered Land Surveyor

DATE: _9-18-73

1983

TELEPHONE TINCTION JUNCTION BOX