SECTION

06 RANGE ADAMS COUNTY COUNTY CORNER NO: 44 ROMPORTOL ID: 41906080020

PUBLIC LAND SURVEY MONUMENT RECORD


SURVEY NAIL TYPE OF MONUMENT: ADAMS COUNTY COORDINATES, NAD 83 (2007) N. 277002.284 E. 533463.454 DATUM **ELEVATION-**12/03/2018 FIELD WORK DATE:

BASIS FOR MONUMENT LOCATION

1971 - PLS 981 FOUND PK NAIL AND SET HARRISON MONUMENT. TIED OUT CORNER.

2008 - PLS 1452 FOUND "PK" NAIL ON 9-8-2008. PRIOR TO 2008 RESURFACING PROJECT, SET NEW REFERENCE MONUMENTS (4" ALUMINUM DISKS SET IN CONCRETE) ON 10-2-2008. RE-SET SECTION CORNER ON 11-3-2008 WITH A BERNTSEN NAIL AND MEASURED TIES.

2018 - PLS 2675 FOUND A SURVEY NAIL IN THE ROAD SURFACE AND 4 TIES. REMOVED THE SURVEY NAIL AND FOUND NO OTHER EVIDENCE OF ANY ADDITIONAL MONUMENTATION BELOW. THE MONUMENT LOCATION AGREES WITH THE EXISTING TIES. ACCEPTED THE SURVEY NAIL LOCATION AS THE CORNER LOCATION. RE-SET SURVEY NAIL AND RE-MEASURED TO THE EXISTING TIES.

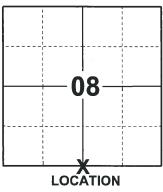

(INDICATE CORNER BY "X")




DATA SHOWN HERE ON THIS TIE SHEET IS CORRECT AND COMPLETE TO THE BEST OF MY KNOWLEDGE AND BELIEF.


PROFESSIONAL LAND SURVEYOR

DATE

-TIE SKETCH

NOTE: THE CORNER FALLS 11'± WEST OF THE CENTERLINE OF STH 13 AND 13'± SOUTH OF THE CENTERLINE OF BIGHORN AVE.

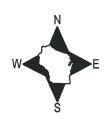

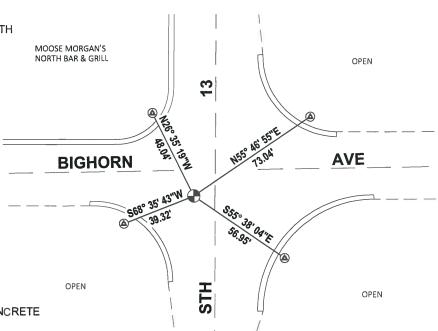

FOUND WISDOT ALUMINUM CAP IN CONCRETE

FOUND SURVEY NAIL

ADAMS COUNTY

Survey Monument Record

		**	
TYPE OF MONU	JMENT:	Berntsen Nail	
STATE PLANE (COORDINATES: N		
	E		_
ELEVATION —	M.S.L. DATUM;		
THETA ANGLE:			·
FIELD BOOK:		PAGE	
DRAWN BY:	D. Christie		

BASIS FOR MONUMENT LOCATION

(Use reverse side if necessary)


Show info such as: History of corner, with reference to Vol. and pg, dates, surveyor, exact description of monument replaced; if location computed, by taped or EDM traverse; landowner remarks, etc.

Found "PK" nail on 9-8-2008, prior to 2008 Resurfacing Project. Set new reference monuments (4" Alum, Disks set in concrete) on 10-2-2008. Re-set section corner on 11-3-2008 and measured Ties.

SAM T. MULLEN TIE SHEET 11-18-71 SEE

CORNER NO. 44 **17 SECTION** 19 N TOWN 6 E **RANGE** LOCATION (Indicated by 'X')


SEAL:

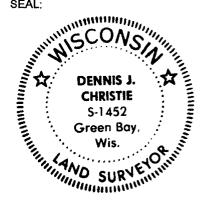

CERTIFIED CORREC Registered Land Surveyor
12-12-2008 Date:

TIE SKETCH

(Show at least four ties)

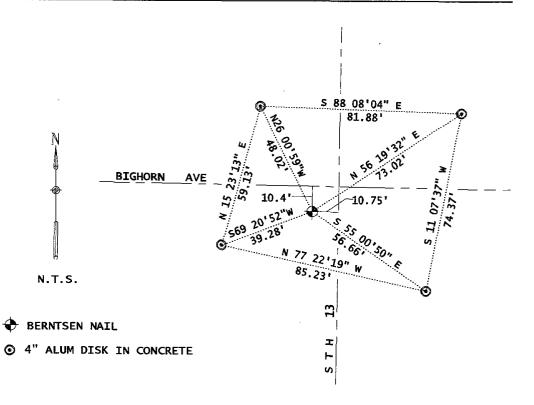

ADAMS COUNTY	CORNER NO
	SECTION
Survey Monument Record TYPE OF MONUMENT: 30" HARRISON (P.K. OVER HARRISON - 1989)	TOWN
STATE PLANE COORDINATES: N	RANGE6_
E	
ELEVATION — M.S.L. DATUM: THETA ANGLE:	4
FIELD BOOK: 104 PAGE 99	
BASIS FOR MONUMENT LOCATION	
(Use reverse side if necessary)	
Show info such as: History of corner, with reference to Vol. and pg, dates, surveyor; exact description of monument replaced; if location computed, by taped or EDM traverse; landowner remarks, etc.	LOCATION (Indicated by 'X') SEAL:
Found PK nail and set monument	SEE UPPATE 12-12-08 DENNIS CHRISTIE
November 18,1971	DENNIS CARISITE
Sam T. Mullen R.L.S. S-981 3-25-83 GR-55 3 NEW 7165 2-1-88 GR-55 1-GONE 1-4-93 JG-BS 1-GONE 2-NEW, 2/24/98 JG-55 OK, 5-19-03 JG-35 OK, 11-14-07-JG-JS NORTHER TOP NIPANCE	CERTIFIED CORRECT: Registered Land Surveyor DATE:
TIE SKETCH	2/11/2
(Show at least four ties)	74" ROD SET AT EAST
CONCRETE MODIFICATION T	Garrier -
	9
NORWAY PINE	
* 8 1 1 1 1 5 0 1 1 1 1 5 0 1 1 1 1 1 5 0 1 1 1 1	
- 18150'	BIGHORN AYE.
, o n	
POWER POLE CONCRETE MANUMENT IN NORWA	HAIL IN POWER POLE TO ABOVE GROUND (1989)
3/4"x 24" IRON ROD SET O.3' NORTH OF STEEL R.O.W. POST (1989)	
X. 0.14. FOOT C	