

09
SECTION

19
TOWN

06
RANGE

ADAMS COUNTY

COUNTY CORNER NO: 47

ROMPORTOL ID: 41906090000

PUBLIC LAND SURVEY MONUMENT RECORD


TYPE OF MONUMENT: HARRISON
ADAMS COUNTY COORDINATES, NAD 83 (2007)

N. 277041.565

E. 541352.485

ELEVATION- _____ DATUM _____

FIELD WORK DATE: 11/29/2018

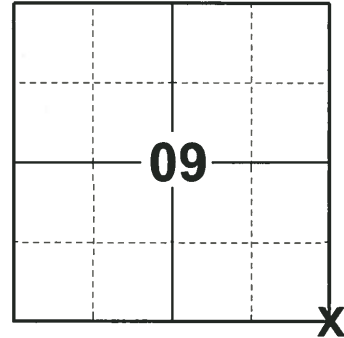

LOCATION

(INDICATE CORNER BY "X")

SEAL:





DATA SHOWN HERE ON THIS TIE SHEET IS CORRECT AND COMPLETE TO THE BEST OF MY KNOWLEDGE AND BELIEF.

PROFESSIONAL LAND SURVEYOR

DATE 1-18-19

TIE SKETCH

NOTE: THE CORNER FALLS 5± NORTH OF THE CENTERLINE OF BIGHORN AVE AND 1± EAST OF THE CENTERLINE OF 10TH AVE.

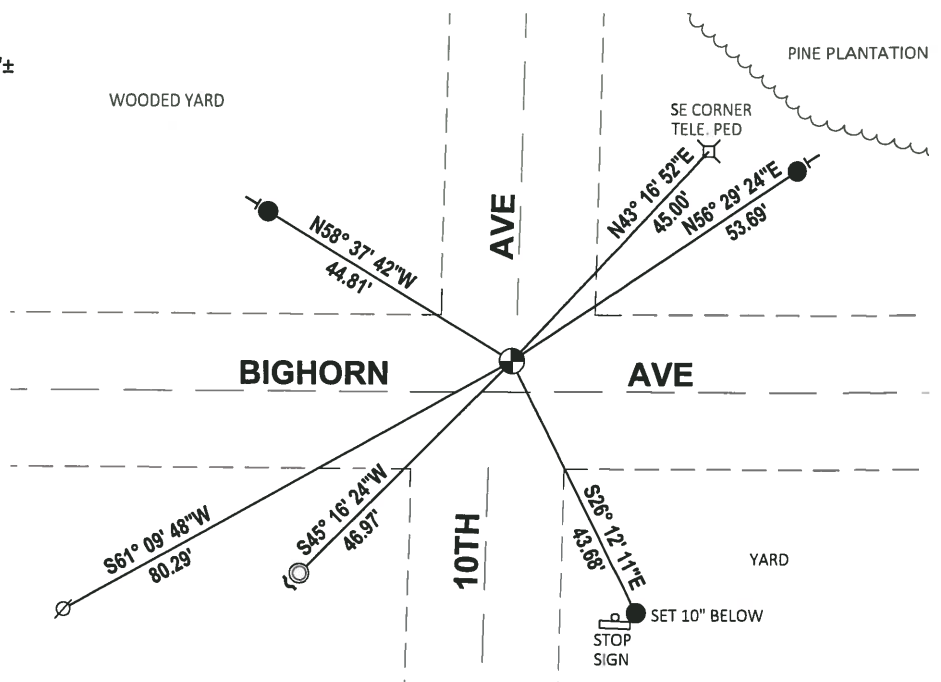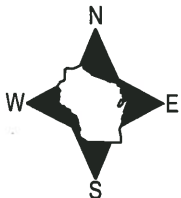


- SET 3/4" x 18" IRON REBAR, 1.50#/FT
- FOUND 1-1/4" O.D. IRON PIPE
- FOUND HARRISON MONUMENT
- WITNESS POWER POLE
- ✓ STEEL FENCE POST
- VINYL "T" POST

Government Land Corner Certificate

ADAMS County
 TYPE OF MONUMENT: HARRISON STANDARD
 STATE PLANE COORDINATES: N _____
 E _____
 ELEVATION — M.S.L. DATUM: _____
 THETA ANGLE: _____
 FIELD BOOK: 54 PAGE 14
 DRAWN BY: SCOTT SORENSEN

CORNER NO. 47
 SECTION 10
 TOWN 19
 RANGE 6

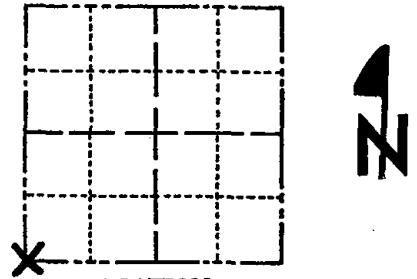

LOCATION
(Indicated by 'X')

BASIS FOR MONUMENT LOCATION

Show info such as: History of corner, with reference to Vol. and pg., dates, surveyor; exact description of monument replaced; if location computed, by taped or EDM traverse; landowner remarks, etc. (Use reverse side if necessary)

No record of resurveys. Excavated large area with backhoe. Found nothing. Corner set by analyzing a traverse a mile in all four directions from here.

SEAL:




DATA SHOWN HERE ON
CERTIFIED CORRECT:

Anthony B. Kiedrowski
 Registered Land Surveyor
 10/31/78

DATE: _____

TIE SKETCH

Show at least four ties, also fence lines, roads, topo, size and type of witness trees' and if off road - best way to arrive at corner.

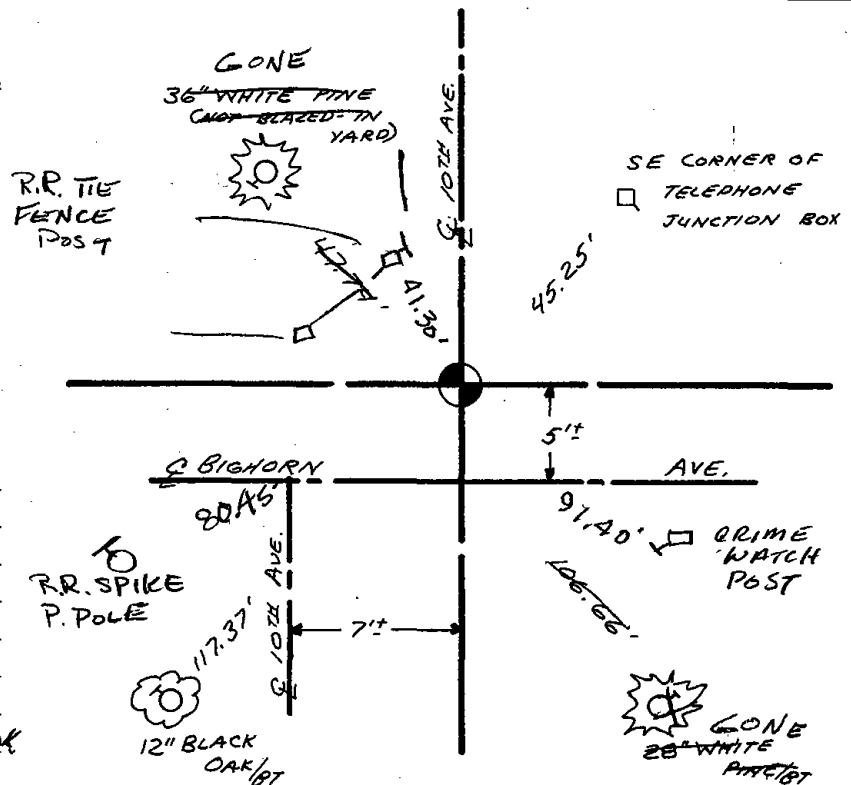

MAINTENANCE RECORD

Date	Init.	Remarks
3-10-83	GR-SS	OK
2-1-88	GR-SS	OK
1-4-93	JG-B5	OK
2-13-98	JG	OK
1-6-03	JG	OK
11-14-07	JG-JS	2-GONE 3-NEW, MON. OK