SECTION

ADAMS COUNTY COUNTY COUNTY CORNER NO: 51 ROMPORTOL ID: 41906110000


PUBLIC LAND SURVEY MONUMENT RECORD

HARRISON TYPE OF MONUMENT: ADAMS COUNTY COORDINATES, NAD 83 (2007) N. **277040.230** E. 551899.992 **ELEVATION-**DATUM 11/28/2018 FIELD WORK DATE:


BASIS FOR MONUMENT LOCATION

1971 - PLS 981 FOUND A 1-1/4" IRON BAR. SET A HARRISON MONUMENT AND TIED OUT.

2018 - PLS 2675 FOUND A HARRISON MONUMENT 10" BELOW THE ROAD SURFACE AND 2 TIES. THE MONUMENT AGREES WITH THE EXISTING TIES, ACCEPTED THE HARRISON MONUMENT AS THE CORNER LOCATION. SET 2 NEW TIES AND MEASURED TO THE TIES.

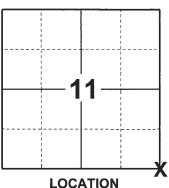

(INDICATE CORNER BY "X")

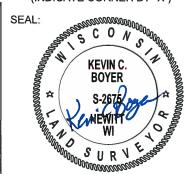

DATA SHOWN HERE ON THIS TIE SHEET IS CORRECT AND COMPLETE TO THE BEST OF MY KNOWLEDGE AND BELIEF.

PROFESSIONAL LAND SURVEYOR

DATE ___ 1-18-19

-TIE SKETCH

NOTE: THE CORNER FALLS 0.5'± SOUTH OF THE CENTERLINE OF BIGHORN AVE AND 0.5'± WEST OF THE CENTERLINE OF 8TH AVE.




SET 3/4" x 18" IRON REBAR, 1.50#/FT

FOUND 3/4" IRON ROD

FOUND HARRISON MONUMENT

VINYL "T" POST

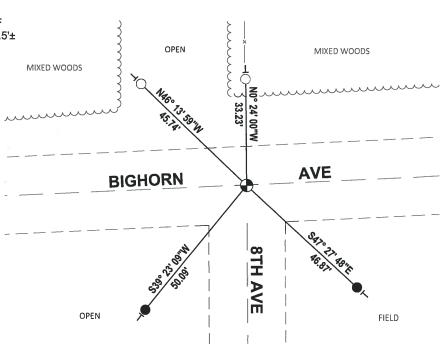

ADAMS COUNTY

Survey Monument Record


TYPE OF MONUMENT: 30" HARRISON

STATE PLANE COORDINATES: N.

ELEVATION - M.S.L. DATUM: __

THETA ANGLE: _

FIELD BOOK: _______ PAGE ______ 79

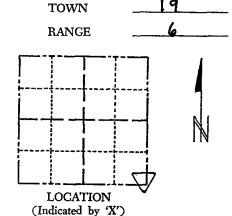

CORNER NO. _

SECTION

SEAL:

BASIS FOR MONUMENT LOCATION

(Use reverse side if necessary)

Show info such as: History of corner, with reference to Vol. and pg, dates, surveyor; exact description of monument replaced; if location computed, by taped or EDM traverse; landowner remarks, etc.

Found $1\frac{1}{4}$ iron bar and set monument

September 1, 1971

Sam T. Mullen R.L.S. S-981

OK 11-24-78 DA-55 CR-SS I NEW TIC 3-10-83 6R-55 Z-1-88 2-GONE 3-NEW TIES, 1-5-93-56-85

OK 2-13-98-50 2-GONE, 2-NEW, MON. OK, 1-28-03-56

CERTIFIED CORRECT:

Registered Land Surveyor

DATE: _

TIE SKETCH

IRON ROD (Show at least four ties) IRON-BAR ROD • -- 33.00 ² BIGHORN 104.12. \$\frac{1}{2} |Z" JACK PINE/87