12 SECTION

ADAMS COUNTY COUNTY CORNER NO: 52 ROMPORTOL ID: 41906120020


PUBLIC LAND SURVEY MONUMENT RECORD

1-1/4" IRON ROD TYPE OF MONUMENT: ADAMS COUNTY COORDINATES, NAD 83 (2007) N. **277071.215** E. 554546.493 ELEVATION-DATUM FIELD WORK DATE: 11/29/2018


BASIS FOR MONUMENT LOCATION

1979 - PLS 878 NO RESURVEYS OF RECORD. EXCAVATED LARGE AREA WITH A BACKHOE AND FOUND NOTHING. CALCULATED THE CORNER LOCATION ON LINE AND EQUIDISTANT BETWEEN SECTION CORNERS. SET A HARRISON MONUMENT AT THE CALCULATED CORNER AND TIED OUT.

2018 - PLS 2675 FOUND A 1-1/4" IRON ROD 2" BELOW THE GROUND SURFACE AND 1 TIE. THE MONUMENT WAS VERIFIED TO BE ON A NEAR STRAIGHT LINE AND EQUIDISTANT BETWEEN THE SE AND SW CORNERS OF SECTION 12. THE MONUMENT ALSO AGREES WITH THE EXISTING TIE. ACCEPTED THE 1-1/4" IRON ROD AS THE CORNER LOCATION. SET 3 NEW TIES AND MEASURED TO THE TIES.

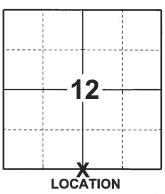

(INDICATE CORNER BY "X")

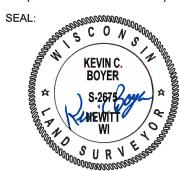


DATA SHOWN HERE ON THIS TIE SHEET IS CORRECT AND COMPLETE TO THE BEST OF MY KNOWLEDGE AND BELIEF.


PROFESSIONAL LAND SURVEYOR

-TIE SKETCH

NOTE: THE CORNER FALLS 32'± SOUTH OF THE CENTERLINE OF BIGHORN AVE.

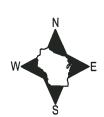

- SET 3/4" x 18" IRON REBAR, 1.50#/FT
- FOUND 3/4" IRON ROD
- FOUND 1-1/4" IRON ROD
- VINYL "T" POST

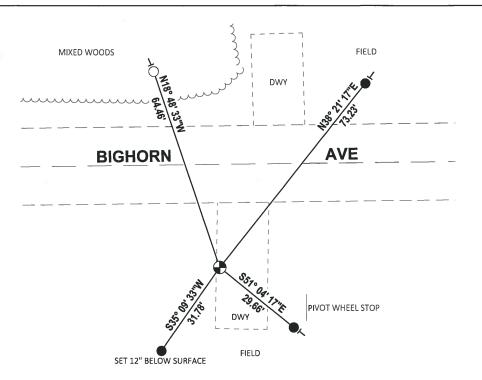

ADAMS County TYPE OF MONUMENT: HARRISON STATE PLANE COORDINATES: N E ELEVATION — M.S.L. DATUM: THETA ANGLE: FIELD BOOK: 54 ((el)) PAGE 53 (e) DRAWN BY: B.S. BASIS FOR MONUMENT LOCATION Show info such as: History of corner, with reference to Vol. and pg., dates, surveyor; exact description of monument replaced; if location computed, by taped or EDM traverse; landowner remarks, etc. (Use reverse side if necessary) No resurveys of record. Excavated large area with backhoe. Found nothing. Corner set on line equidistant between section corners.
TYPE OF MONUMENT: HARRISON STATE PLANE COORDINATES: N ELEVATION — M.S.L. DATUM: THETA ANGLE: FIELD BOOK: 54 ((22) PAGE 53 (4) DRAWN BY: B.S. BASIS FOR MONUMENT LOCATION Show info such as: History of corner, with reference to Vol. and pg., dates, surveyor; exact description of monument replaced; if location computed, by taped or EDM traverse; landowner remarks, etc. (Use reverse side if necessary) SEAL:
STATE PLANE COORDINATES: N E ELEVATION — M.S.L. DATUM: THETA ANGLE: FIELD BOOK: 54 (102) PAGE 53 (4) DRAWN BY: B.S. BASIS FOR MONUMENT LOCATION Show info such as: History of corner, with reference to Vol. and pg., dates, surveyor; exact description of monument replaced; if location computed, by taped or EDM traverse; landowner remarks, etc. (Use reverse side if necessary) SEAL:
ELEVATION — M.S.L. DATUM: THETA ANGLE: FIELD BOOK: 54 (102) PAGE 53 (4) DRAWN BY: B.S. BASIS FOR MONUMENT LOCATION Show info such as: History of corner, with reference to Vol. and pg., dates, surveyor; exact description of monument replaced; if location computed, by taped or EDM traverse; landowner remarks, etc. (Use reverse side if necessary) RANGE LOCATION LOCATION (Indicated by 'X')
THETA ANGLE: FIELD BOOK: 54 (102) PAGE 53 (4) DRAWN BY: B.S. BASIS FOR MONUMENT LOCATION Show info such as: History of corner, with reference to Vol. and pg., dates, surveyor; exact description of monument replaced; if location computed, by taped or EDM traverse; landowner remarks, etc. (Use reverse side if necessary) LOCATION (Indicated by X')
FIELD BOOK: 54 (102) PAGE 53 (4) DRAWN BY: B.S. BASIS FOR MONUMENT LOCATION Show info such as: History of corner, with reference to Vol. and pg., dates, surveyor; exact description of monument replaced; if location computed, by taped or EDM traverse; landowner remarks, etc. (Use reverse side if necessary) LOCATION (Indicated by 'X')
BASIS FOR MONUMENT LOCATION Show info such as: History of corner, with reference to Vol. and pg., dates, surveyor; exact description of monument replaced; if location computed, by taped or EDM traverse; landowner remarks, etc. (Use reverse side if necessary) LOCATION (Indicated by X')
BASIS FOR MONUMENT LOCATION Show info such as: History of corner, with reference to Vol. and pg., dates, surveyor; exact description of monument replaced; if location computed, by taped or EDM traverse; landowner remarks, etc. (Use reverse side if necessary) LOCATION (Indicated by X')
Show info such as: History of comer, with reference to Vol. and pg., dates, surveyor; exact description of monument replaced; if location computed, by taped or EDM traverse; landowner remarks, etc. (Use reverse side if necessary) LOCATION (Indicated by X')
Show info such as: History of comer, with reference to Vol. and pg., dates, surveyor; exact description of monument replaced; if location computed, by taped or EDM traverse; landowner remarks, etc. (Use reverse side if necessary) LOCATION (Indicated by X')
and pg., dates, surveyor; exact description of monument replaced; if location computed, by taped or EDM traverse; landowner remarks, etc. (Use reverse side if necessary) SEAL:
replaced; if location computed, by taped or EDM traverse; landowner remarks, etc. (Use reverse side if necessary) SEAL:
SEAL:
No resurveys of record. Excavated large area with backhoe. Found nothing. Corner set on line equidistant between section corners.
set on line equidistant between section corners.
ANTHONY B.
KIEDROWSKI
S-878 Wisconsin Rapids.
Wis. Vis.
William SUR Report
DATA SHOWN HERE ON
CERTIFIED CORRECT:
Anthon B Kednoch
Registered Land Surbeyor
DATE: <u>5/10/79</u>
TIE SKETCH
Show at least four ties, also fence lines, roads, topo, size
and type of witness trees' and if off road - best way to
ZOOB SET 3/4" POOR 10" NILWAY 2 BLACK OAK B.T.
27.53 ± N 73°E MPINE (1)
30.42 ± 519°W
50.45 ± N82°W
64,23 + N/9 W
ALL BEARING TREES
DESTROYED BY FIRE DOUBLE 14" BLACK OAK BT
ω_{ij}
8"NORWAY
B.T. 12" BLACK OAK
+516N B.T.
$4''$ $\frac{1}{2}$
₹54 Li P I

MAINTENANCE RECORD

DATE	BY WHOM	REMARKS
3-10-83	6R-55	OK
2-1-88	GR-SS	0K
1-5-93	JG-733	TOP BLEKEN OFF MON. Z-GONE, Z-NEW TIES
2-13-98	56	OK
5-20-98	SH-Me	OK
1-24-03	JG	OK
8-11-08	K5-55	TOP BROKEN SET 4 HROOS
	-	