16 SECTION

ADAMS COUNTY COU

PUBLIC LAND SURVEY MONUMENT RECORD


HARRISON TYPE OF MONUMENT: ADAMS COUNTY COORDINATES, NAD 83 (2007) N. **274388.094** E. 541320.514 DATUM

12/04/2018 FIELD WORK DATE:


BASIS FOR MONUMENT LOCATION

1977 - PLS 878 EXCAVATED WITH BACKHOE. FOUND STAIN FROM BOTTOM 24" OF DUG IN POINTED 3" DIAMETER WOOD POST. MONUMENTED THAT POINT WITH A HARRISON MONUMENT. LOCATION VERIFIED BY EDM TRAVERSE. NO RESURVEYS ON RECORD. SET HARRISON AND TIED OUT.

2018 - PLS 2675 FOUND A HARRISON MONUMENT IN ROAD SURFACE AND 2 TIES. THE MONUMENT AGREES WITH THE EXISTING TIES, ACCEPTED THE HARRISON MONUMENT AS THE CORNER LOCATION. SET 2 NEW TIES AND MEASURED TO THE TIES.

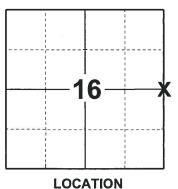

(INDICATE CORNER BY "X")

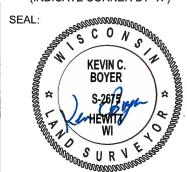

DATA SHOWN HERE ON THIS TIE SHEET IS CORRECT AND COMPLETE TO THE BEST OF MY KNOWLEDGE AND BELIEF.

PROFESSIONAL LAND SURVEYOR


1-18-19

-TIE SKETCH

NOTE: THE CORNER FALLS 7'± WEST OF THE CENTERLINE OF 10TH AVE.



- SET 3/4" x 18" IRON REBAR, 1.50#/FT
- FOUND 1-1/4" O.D. IRON PIPE
- FOUND HARRISON MONUMENT
- STEEL FENCE POST
- VINYL "T" POST

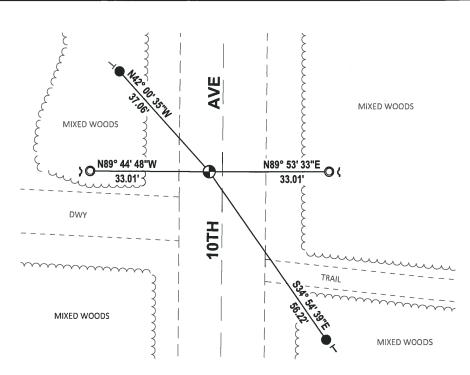

Government Land Corner Certificate CORNER NO. ____57 County ADAMS SECTION TYPE OF MONUMENT: __HARRISON 19N TOWN STATE PLANE COORDINATES: 6E RANGE ELEVATION — M.S.L. DATUM: _ THETA ANGLE: ___ _ PAGE _*82* DRAWN BY: ____LANCE HABECK BASIS FOR MONUMENT LOCATION ANTHONY B. KIEDROWSKI S-878 Wisconsin Rapids, Wis. Show info such as: History of corner, with reference to Vol. and pg., dates, surveyor; exact description of monument replaced; if location computed, by taped or EDM traverse; landowner remarks, etc. (Use reverse side if necessary) SEAL: Excavated with backhoe. Found stain from bottom 24" of dug in pointed 3" diameter wood post. Monumented that point with a Harrison monument. Location verified by EDM traverse. No resurveys on record. PN-DA 11-27.78 OK DATA SHOWN HERE ON CERTIFIED CORRECT: Registered Land Surveyor DATE: 5/26/77 TIE SKETCH Show at least four ties, also fence lines, roads, topo, size and type of witness trees' and if off road - best way to B" BIK OAK 10°BIK 08 arrive at corner. . 4 9 & 912c 104 POWER POLE MAINTENANCE RECORD Date Remarks 3-10-83 6R-55

31

'n POWER

POLE

NORWAY

REVISED 1977

1-6-03

7-31-08

1-4-93 TG-BS

STS

2-13-98 JG

OK

OK

aĸ

OK

Z NEW TYES