15 SECTION

# ADAMS COUNTY COUNTY CORNER NO: 58 ROMPORTOL ID: 41906152000


## PUBLIC LAND SURVEY MONUMENT RECORD

**HARRISON** TYPE OF MONUMENT: ADAMS COUNTY COORDINATES, NAD 83 (2007) N. **274389.881** E. 546598.989 DATUM 12/04/2018 FIELD WORK DATE:


### **BASIS FOR MONUMENT LOCATION**

1978 - PLS 878 NO RECORD OF RESURVEYS, EXCAVATED WITH A BACKHOE AND FOUND NO EVIDENCE OF THE CORNER, CALCULATED THE CORNER LOCATION ON A STRAIGHT LINE AND EQUIDISTANT BETWEEN SECTION CORNERS. SET HARRISON MONUMENT AND TIED OUT.

2018 - PLS 2675 FOUND A HARRISON MONUMENT 12" BELOW THE ROAD SURFACE, 2. TIES AND 1 WITNESS. THE MONUMENT AGREES WITH THE EXISTING TIES AND WITNESS. ACCEPTED THE HARRISON MONUMENT AS THE CORNER LOCATION. SET 2 NEW TIES AND MEASURED TO THE TIES AND WITNESS.

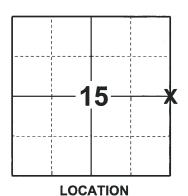

(INDICATE CORNER BY "X")

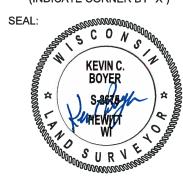

DATA SHOWN HERE ON THIS TIE SHEET IS CORRECT AND COMPLETE TO THE BEST OF MY KNOWLEDGE AND BELIEF.

PROFESSIONAL LAND SURVEYOR


-18-19

#### -TIE SKETCH

NOTE: THE CORNER FALLS 6'± EAST OF THE CENTERLINE OF 9TH AVE.



- SET 3/4" x 18" IRON REBAR, 1.50#/FT
- FOUND 3/4" IRON ROD
- FOUND HARRISON MONUMENT
- STEEL FENCE POST
- VINYL "T" POST

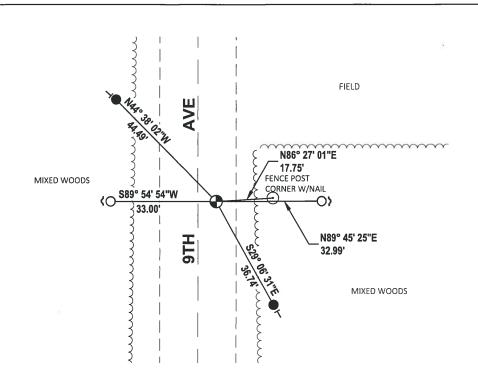


## Government Land Corner Certificate CORNER NO. ADAMS County SECTION STANDARD TYPE OF MONUMENT: HARRISON TOWN STATE PLANE COORDINATES: RANGE ELEVATION - M.S.L. DATUM: THETA ANGLE: \_\_ 54 FIELD BOOK: \_ . PAGE \_\_\_ DRAWN BY: SCOTT SORENSEN BASIS FOR MONUMENT LOCATION Show info such as: History of corner, with reference to Vol. and pg., dates, surveyor; exact description of monument replaced; if location computed, by taped or EDM traverse; landowner remarks, etc. (Use reverse side if necessary) ANTHONY B. KIEDROW LOCATION SEAL: No record of resurveys. Excavated with backhoe. Found nothing. Corner set on a straight line equidistant between section corners. Wis. DATA SHOWN HERE ON CERTIFIED CORRECT: Registered Land Surveyor 10/31/78 DATE: TIE SKETCH Show at least four ties, also fence lines, roads, topo, size and type of witness trees' and if off road - best way to arrive at corner.

REVERSE SIDE SEE FOR NEW SKETCH 07-31-08

#### MAINTENANCE RECORD

W, MON. OK

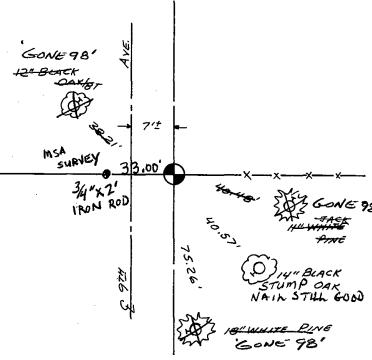

MEA SURVEY

33.00'

3/4" IRON ROD

17.75"

PK NAIL/DND SIGN

R.P. THE FENCE COLNER

ROD, OF MAIL STILL GOOD)

10" BLK OAK/BT
IN CLUSTER