18 SECTION

# 06 RANGE ADAMS COUNTY COUNTY CORNER NO: 63 ROMPORTOL ID: 41906180000

## PUBLIC LAND SURVEY MONUMENT RECORD

**HARRISON** TYPE OF MONUMENT: ADAMS COUNTY COORDINATES, NAD 83 (2007) N. **271688.319** E. 530811.369 DATUM 12/05/2018 FIELD WORK DATE:


#### BASIS FOR MONUMENT LOCATION

1971 - PLS 981 FOUND NAIL AND SET HARRISON MONUMENT. TIED OUT CORNER.

2018 - PLS 2675 FOUND HARRISON 6" BELOW THE ROAD SURFACE AND FOUND NO EVIDENCE OF ANY OF THE TIES OR WITNESSES, ACCEPTED HARRISON MONUMENT AS THE BEST EVIDENCE OF THE CORNER LOCATION. SET 4 NEW TIES AND MEASURED TO THE TIES.



(INDICATE CORNER BY "X")

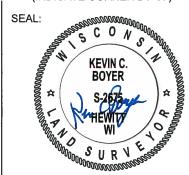

DATA SHOWN HERE ON THIS TIE SHEET IS CORRECT AND COMPLETE TO THE BEST OF MY KNOWLEDGE AND BELIEF.

OPEN

PROFESSIONAL LAND SURVEYOR

1-18-19

#### -TIE SKETCH

NOTE: THE CORNER FALLS 6'± SOUTH OF THE CENTERLINE OF CTH C AND 19'± WEST OF THE CENTERLINE OF 13TH AVE.



OPEN C **CTH** TREE LINE 3TH WOODED YARD

SET 3/4" x 18" IRON REBAR, 1.50#/FT


FOUND HARRISON MONUMENT

VINYL "T" POST

### Government Land Corner Certificate CORNER NO. **ADAMS** County SECTION TYPE OF MONUMENT: Harrison standard 19 TOWN STATE PLANE COORDINATES: N\_\_\_\_ RANGE ELEVATION - M.S.L. DATUM: \_ THETA ANGLE: \_\_\_\_\_ FIELD BOOK: \_\_\_\_ \_\_\_\_\_\_ PAGE \_ DRAWN BY: \_\_\_ BASIS FOR MONUMENT LOCATION Show info such as: History of corner, with reference to Vol. and pg., dates, surveyor; exact description of monument replaced; if location computed, by taped or EDM traverse; landowner remarks, etc. (Use reverse side if necessary) . LOCATION (Indicated by X') SEAL: This is an updated tie sheet to show ties in place after monument was reset following road construction. S.T. MUCLEN, 11-18-71, SEE ADDITIONAL INFORMATION. AUG ZOUD DATA SHOWN HERE ON CERTIFIED CORRECT: Registered Land Surveyor DATE: TIE SKETCH Show at least four ties, also fence lines, roads, topo, size and type of witness trees' and if off road - best way to arrive at corner. CONCRETE MONUMENT

#### MAINTENANCE RECORD

Date	Init.	Remarks
2-30-02	JG	0K
2-30-02 2-21-07	JG-55	OK
		· · · · · · · · · · · · · · · · · · ·
		·····

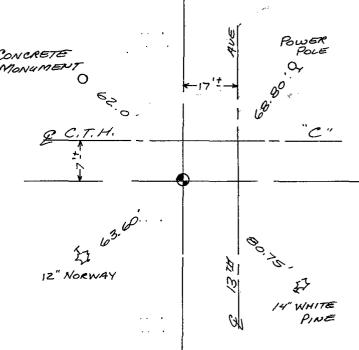

AT AME COLLETING	6.
ADAMS COUNTY	CORNER NO. 67 SECTION 17
Survey Monument Record	52 <b>521</b> 511
TYPE OF MONUMENT: 30" HARRISON	TOWN
STATE PLANE COORDINATES: NE	RANGE 6
ELEVATION — M.S.L. DATUM:	
THETA ANGLE:	
FIELD BOOK: PAGE96	
BASIS FOR MONUMENT LOCATION	
(Use reverse side if necessary)	· <u>A-1-1-1</u>
Show info such as: History of corner, with reference to Vol. and pg, dates, surveyor; exact description of monument replaced; if location computed, by taped or EDM traverse; landowner remarks, etc.	LOCATION (Indicated by 'X') SEAL:
Found nail and set monument	
November 18, 1971	
Sam T. Mullen R.L.S. S-981	
OK 11-27-78 RN-DA 3-11-83 GR SS OK 1-GONE 1-4-93 JG-BS 3-GONE, 3-NEW, MON.OK, 2-11-98-JG 1-GONE, 4-LEFT, 12-30-02, -JG	CERTIFIED CORRECT:  Registered Land Surveyor  DATE:
TIE SKETCH	
(Show at least four ties)	
Ave	CONFE 98'