17 SECTION

ADAMS COUNTY COU

PUBLIC LAND SURVEY MONUMENT RECORD

HARRISON TYPE OF MONUMENT: ADAMS COUNTY COORDINATES, NAD 83 (2007) N. **271767.884** E. 536063.928 DATUM - -12/05/2018 FIELD WORK DATE:

BASIS FOR MONUMENT LOCATION


1971 - PLS 981 SET HARRISON MONUMENT AND TIED OUT CORNER.

2000 - PLS 2281 RESET HARRISON MONUMENT AFTER COMPLETION OF COUNTY HIGHWAY 'C' RECONSTRUCTION PROJECT. LOCATION IS BASED ON THE EXISTING MONUMENT FOUND BEFORE CONSTRUCTION BEGAN.

2018 - PLS 2675 FOUND A MAG NAIL IN THE ROAD SURFACE, 4 TIES AND 2 PROPERTY IRONS. REMOVED THE MAG NAIL AND FOUND A HARRISON MONUMENT 4" BELOW THE ROAD SURFACE. THE MONUMENT AGREES WITH THE EXISTING TIES. ACCEPTED THE HARRISON MONUMENT AS THE CORNER LOCATION. MEASURED TO THE TIES AND PROPERTY IRONS.



(INDICATE CORNER BY "X")

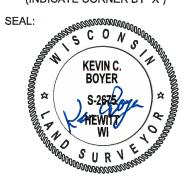

DATA SHOWN HERE ON THIS TIE SHEET IS CORRECT AND COMPLETE TO THE BEST OF MY KNOWLEDGE AND BELIEF.

PROFESSIONAL LAND SURVEYOR


1-18-19 DATE

-TIE SKETCH

NOTE: THE CORNER FALLS 1'± NORTH OF THE CENTERLINE OF CTH C AND 27'± WEST OF THE CENTERLINE OF 11TH AVE.



- O FOUND 3/4" IRON ROD
- FOUND 1-1/2" O.D. IRON PIPE
- FOUND 2-3/8" O.D. IRON PIPE
- FOUND HARRISON MONUMENT
- VINYL "T" POST

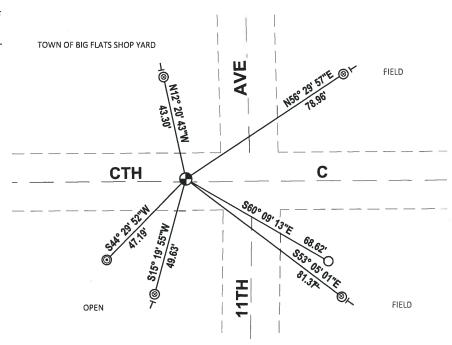

ADAMS COUNTY U.S. PUBLIC LAND	SURVEY	CORNER # 65
MONUMENT LOCATION RECORD		SECTION 17 TOWNSHIP 19 NORTH
	☐ FOUND ☐ SET	RANGE 6 EAST
IX LANDMARK □ BENCHMARK: CORNER IDENTITY: SOUTH EAST QUATER CONER	$X RE-SET$ $\square RE-TIED$	SECTION 17
STATE PLANE COORDINATE: N:		
E:		
ZONE:)	
ELEVATION:		
DATUM:	XX	
THETA ANGLE: WEATHER: SUNNY/COLD TEMPERATURE: 58° F	I I	
DATE OF SURVEY: 11/4/99	i	
SURVEY PARTY: MARK HINTZ / CHRIS THORSON	•	LOCATION
		
BASIS FOR MONUMENT LOCATION:	, =	SEAL
(DESCRIBE METHOD OF SURVEY AND CORNER AUTHENTICATION)		
HARRISON MONUMENT RESET AFTER COMPLETION OF		Marian Maria
COUNTY HIGHWAY C RECONSTRUCTION PROJECT. LOCATION	ني	
IS BASED ON THE EXISTING MONUMENT FOUND BEFORE CONSTRUCTION BEGAN.	3000	SCOTT B
SEE ATTACHED TIE SHEET	1	GROUPASKI ASKĒ
- · ·		
SAM MULLEN 1971		
		1.00
	AH	
	SCOTT GRO	OHOLSKI (RLS #2281)
·	DATE	121/00
		/
TIE SKETCH: SHOW MINIMUM OF FOUR (4) HORIZONT DESCRIBE ALL MONUMENTS FOUND OR		
TEMPERATURE OF 68° F.	DD1. COMMENT TIME.	DRAWING IS NOT TO SCALE.
* *		LEGEND
TOWN OF BIG FLATS GARAGE		TELEPHONE PERALSTAL
/		☐ TELEPHONE PEDALSTAL → HARISON MONUMENT SET
		XX EDGE OF BITUMINOUS
POWER POLE		— CENTER LINE
	GUY POLE	
XX XX (7)		
XX XX XX	XX	XX XX XX
XX XX XX XX	~~	XX XX
	J. N.	
	\\\\\\\\\\\\\\\\\\\\\\\\\\\\\\\\\\\\\\	
Q AVENUE		
	()	
HI		
× 11 ×		,

ADAMS COUNTY	CORNER NO. 7/
Survey Monument Record	SECTION 21
TYPE OF MONUMENT: 30" HARRISON	TOWN 19
STATE PLANE COORDINATES: N	range 6
E	A
ELEVATION — M.S.L. DATUM:	4
THETA ANGLE:	
FIELD BOOK: 104 PAGE 100	
BASIS FOR MONUMENT LOCATION	
(Use reverse side if necessary)	
Show info such as: History of corner, with reference to Vol. and pg, dates, surveyor; exact description of monument replaced; if location computed, by taped or EDM traverse; landowner	LOCATION (Indicated by 'X') SEAL:
remarks, etc.	
Set monument	
November 19,1971	•
C M	
Sam T. Mullen R.L.S. S-981	
OK 11-24-78 DA-SS 3-11-82 GR-SS I NEW OK - 10/5/92-56	CERTIFIED CORRECT:
3-60NE, 3-NEW, 2/24/98 JG-SS SEE ATTACHED SHEET, CROHOLSKI, 1/21/00 OK, 1-6-03-JC	Registered Land Surveyor
OK, 1-6-03-JC	DATE:
TIE SKETCH	
(Show at least four ties) $C^{S_{\mu}}$	NEW
	B.R. SPIKE POWER POLE
A.A. SPIKE BOWER POLE	CS M 76
OF GONE NEW PK NAIL Bb.60	0 41
PK NAIL POWER POLE 7	EAST OF &
10 Parties 110	CAPPED
R 597 142.60 27.40 27.40	PIPE
0 507 14260 - 3740	<u>\$ 674. "C"</u>
~ ×1 - // / / / / / / / / / / / / / / / / /	
The public	
The public	
The public of the state of the	
The property of the state of th	
CONE MAN CONE MAN CON CON CON CON CON CON CON CON CON CO	
CONE PROPERTO	
CONE MAN CON	
CONE MAN CONE	

REVISED 1972