ADAMS COUNTY COUNTY COUNTY CORNER NO: 66 ROMPORTOL ID: 41906160020

PUBLIC LAND SURVEY MONUMENT RECORD


HARRISON TYPE OF MONUMENT: ADAMS COUNTY COORDINATES, NAD 83 (2007) N. 271761.565 E. 538716.014 **ELEVATION-**DATUM 12/05/2018 FIELD WORK DATE:

BASIS FOR MONUMENT LOCATION


1971 - PLS 981 SET HARRISON MONUMENT AND TIED OUT CORNER.

2000 - PLS 2281 RESET HARRISON MONUMENT AFTER COMPLETION OF COUNTY HIGHWAY 'C' RECONSTRUCTION PROJECT. LOCATION IS BASED ON THE EXISTING MONUMENT FOUND BEFORE CONSTRUCTION BEGAN.

2018 - PLS 2675 FOUND A MAG NAIL IN ROAD SURFACE AND 4 TIES, REMOVED THE MAG NAIL AND FOUND A HARRISON MONUMENT 4" BELOW ROAD SURFACE. THE MONUMENT AGREES WITH THE EXISTING TIES. ACCEPTED THE HARRISON MONUMENT AS THE CORNER LOCATION AND RE-MEASURED TO THE EXISTING TIES.

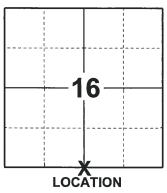

(INDICATE CORNER BY "X")

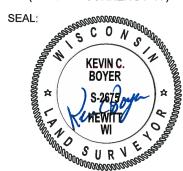

DATA SHOWN HERE ON THIS TIE SHEET IS CORRECT AND COMPLETE TO THE BEST OF MY KNOWLEDGE AND BELIEF.


PROFESSIONAL LAND SURVEYOR

-TIE SKETCH -

NOTE: THE CORNER FALLS 11'± SOUTH OF THE CENTERLINE OF CTH C.



- FOUND 1-1/2" O.D. IRON PIPE
- FOUND 1-1/4" O.D. IRON PIPE
- FOUND HARRISON MONUMENT
- VINYL "T" POST

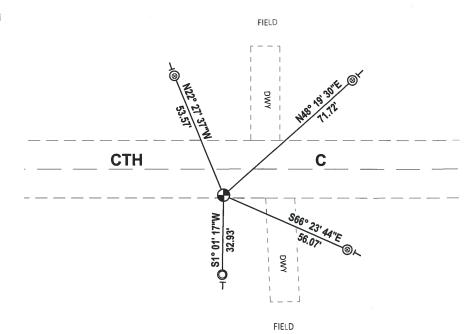

ADAMS COUNTY U.S. PUBLIC LAND	SURVEY	CORNER # 6
MONUMENT LOCATION RECORD		SECTION 16 TOWNSHIP 19 NORTH
	☐ FOUND ☐ SET	RANGE 6 EAST
	X RE-SET $RE-TIED$	SECTION 16
STATE PLANE COORDINATE: N:	_	
E:		
ZONE:	,	
ELEVATION:		
DATUM:		
THETA ANGLE:		
DATE OF SURVEY: 11/4/99	i	
SURVEY PARTY: MARK HINTZ / CHRIS THORSON	•	LOCATION
BASIS FOR MONUMENT LOCATION: (DESCRIBE METHOD OF SURVEY AND CORNER AUTHENTICATION)		SEAL
HARRISON MONUMENT RESET AFTER COMPLETION OF COUNTY HIGHWAY C RECONSTRUCTION PROJECT. LOCATION IS BASED ON THE EXISTING MONUMENT FOUND BEFORE CONSTRUCTION BEGAN.		SCOTT R GROPOLSKI
		CUSTER :
SEE ATTACHED TIE SHEET		
SAM MULLETY 11-23-71	137	A. C.
		Tunnanist.
·	SCOTT GRO	HOLSKI (RLS #2281)
	1/2	21/00 21/00
	DATE	
TIE SKETCH: SHOW MINIMUM OF FOUR (4) HORIZONT DESCRIBE ALL MONUMENTS FOUND OR		
TEMPERATURE OF 68° F	SET. CURRECT ALL L	DISTANCES SHOWN TO STANDARD DRAWING IS NOT TO SCALE.
LEGEND © 1 1/4" IRON PIPE SET		DRAWING IS NOT TO SUMBE.
#10 REBAR W/CAP		
→ HARISON MONUMENT SET XX EDGE OF BITUNINOUS CENTER LINE		
,	PLACED	
Q / P	POST/SIEN 108	
XX XX XX XX XX	XX XX	XX XX XX
XX		<u>CTH_ C</u>
		<u></u>
XX XX XX	XXXX	
55,89	Post/sign '08	
CRAVEL DRIVE	108	
GRAVE		

	(6)	
ADAMS COUNTY	CORNER NO. 72	
Survey Monument Record	SECTION 21	
TYPE OF MONUMENT: _30" HARRISON	TOWN 19	
STATE PLANE COORDINATES: N	RANGE6	
E		
ELEVATION — M.S.L. DATUM:	4	
THETA ANGLE:	A	
FIELD BOOK: PAGE 101		
DAGTO HOD A COMMISSION AND A COMMISSION		
BASIS FOR MONUMENT LOCATION	i i i i	
(Use reverse side if necessary)	1.0048703	
Show info such as: History of corner, with reference to Vol. and pg, dates, surveyor; exact description of monument replaced; if location computed, by taped or EDM traverse; landowner remarks, etc.	LOCATION (Indicated by 'X') SEAL:	
	SEE ATTACHED	
	TIE SHEET BY	
Set monument	GROMOLSKI 01-21-00	
	S ,	
November 23, 1971		
SamT. Mullen R.L.S. S-981		
OK 11-27-78 RN-DA 3-25-83 GR-SS - TREES GONE		
3-25-83 GR-SS - TREES GONE		
OK - 10/5/92 - JG	CERTIFIED CORRECT:	
3-60NE, 2-NEW, 2/24/98 JG-59 TOP BROKEN MON.		
SEE ATTACHED SHEET GROHOLSKI, 1/21/00		
OK, 1-6-03-JG	DATE:	
TIE SKETCH PLL OK, 12-17-09- 56-55		
(Show at least four ties)		
C5 M 976		

