14 SECTION

ADAMS COUNTY COU

PUBLIC LAND SURVEY MONUMENT RECORD


HARRISON TYPE OF MONUMENT: ADAMS COUNTY COORDINATES, NAD 83 (2007) N. **271774.865** E. 551909.947 **ELEVATION-**DATUM 12/04/2018 FIELD WORK DATE:

BASIS FOR MONUMENT LOCATION

1978 - PLS 878 EXCAVATED WITH BACKHOE AND FOUND THE BOTTOM 18" OF A 3" DIA. WOOD STAKE, POINTED, ACCEPTED AS THE CORNER LOCATION AFTER RUNNING AN EDM TRAVERSE OF THE SECTION. WITNESSED BY LOCAL LANDOWNER HERB PETERSON, SET A HARRISON MONUMENT AND TIED OUT.

2000 - PLS 2281 RE-SET HARRISON MONUMENT AFTER COMPLETION OF COUNTY HIGHWAY 'C' RECONSTRUCTION PROJECT. LOCATION IS BASED ON THE EXISTING MONUMENT FOUND BEFORE CONSTRUCTION BEGAN.

2018 - PLS 2675 FOUND HARRISON MONUMENT 6" BELOW THE ROAD SURFACE AND 4 TIES, THE MONUMENT AGREES WITH THE EXISTING TIES, ACCEPTED THE HARRISON MONUMENT AS THE CORNER LOCATION AND RE-MEASURED TO THE EXISTING TIES.

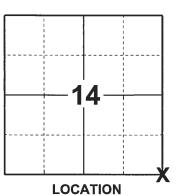

(INDICATE CORNER BY "X")



DATA SHOWN HERE ON THIS TIE SHEET IS CORRECT AND COMPLETE TO THE BEST OF MY KNOWLEDGE AND BELIEF.

PROFESSIONAL LAND SURVEYOR

-18 -19

-TIE SKETCH


NOTE: THE CORNER FALLS 2'± NORTH OF THE CENTERLINE OF CTH C AND 2'± WEST OF THE CENTERLINE OF 8TH AVE.



FOUND 1-1/2" O.D. IRON PIPE

FOUND HARRISON MONUMENT

VINYL "T" POST

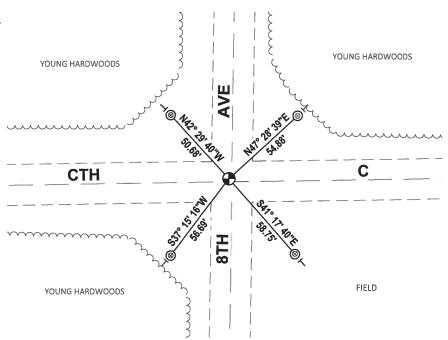

ADAMS COUNTY U.S. PUBLIC LAND	SURVEY	CORNER #
MONUMENT LOCATION RECORD	_	SECTION 14 TOWNSHIP 19 NORTH
	☐ FOUND ☐ SET	TOWNSHIP 19 NORTH RANGE 6 EAST
X LANDMARK □ BENCHMARK: CORNER IDENTITY: SOUTH EAST QUATER CONER	$egin{array}{c} ar{X} & RE-SET \ \hline & RE-TIED \end{array}$	SECTION 14
STATE PLANE COORDINATE: N:		
E:		
ZONE:	1	
ELEVATION:	A. I	
THETA ANGLE:		
WEATHER: SUNNY/COLD TEMPERATURE: 58° F	1	
DATE OF SURVEY: 11/4/99		
SURVEY PARTY: MARK HINTZ / CHRIS THORSON		LOCATION
BASIS FOR MONUMENT LOCATION:	.	SEAL
(DESCRIBE METHOD OF SURVEY AND CORNER AUTHENTICATION)	-	.autiliting,
TARREST MANAGERS PROPER ARREST COMPLETENCE OF	, , , , , , , , , , , , , , , , , , ,	Weed North
HARRISON MONUMENT RESET AFTER COMPLETION OF COUNTY HIGHWAY C RECONSTRUCTION PROJECT. LOCATION	200	Commence of the second
IS BASED ON THE EXISTING MONUMENT FOUND BEFORE CONSTRUCTION BEGAN.		· Grotolsti
8-11-08 KS-SS PLACED STEEL POST @ IRONS	- pec, v	SAMO PORTER OF THE
SEE ATTACHED TIE SHEET ABK 1978	11	1. Company of the
·-· ·	1//	Marine Marine
	M	4
		CHOLSKI (RLS #2281)
	DATE	Zi/00
TIE SKETCH: SHOW MINIMUM OF FOUR (4) HORIZON?		
DESCRIBE ALL MONUMENTS FOUND OR TEMPERATURE OF 68° F		DISTANCES SHOWN TO STANDARD
LEGEND) k	(DRAWING IS NOT TO SCALE.
○ 1 1/4" IRON PIPE SET □ TELEPHONE PEDALSTAL ○ □ TELEPHONE PEDALSTAL	}	
+ HARISON MONUMENT SET	}	
XX EDGE OF BITUMINOUS	Lum	EDGE OF WOODS
	1	
XX	2.4	
XX XX XX	^ ^ ^	XX XX
	· ~ ~	
XX		
XX XX XX	XX	XXXXXX
357	E XX	
** _{E3}	X	
EDCE OF WOODS	/ 🔊	
	EDGE OF	EDGE OF FIELD
} } HTH ↓	FOODS)))
/ K 1 ×1	()

Government Land Corner Certificate

Adams County	
TYPE OF MONUMENT: Harrison Monument	
STATE PLANE COORDINATES: N	
В	
ELEVATION — M.S.L. DATUM:	
THETA ANGLE:	. \
THETA ANGLE: FIELD BOOK: 54 (101) PAGE 23 (98)	3 /
DRAWN BY: Scott SORENSEN	

BASIS FOR MONUMENT LOCATION

Show info such as: History of corner, with reference to Vol. and pg., dates, surveyor; exact description of monument replaced; if location computed, by taped or EDM traverse; landowner remarks, etc. (Use reverse side if necessary)


EXcavated with backhoe. Found bottom 18" of 3" dia wood stake, pointed. Accepted as the corner after running an EDM traverse of the section. Witnessed by local landowner Herb Peterson.

CORNER NO. SECTION TOWN RANGE





SEAL:

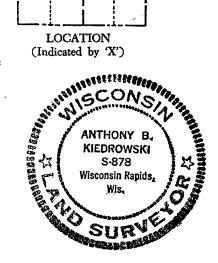

DATA SHOWN HERE ON CERTIFIED CORRECT:

Archen & King Registered Land Surveyor

DATE 1/16/78

TIE SKETCH

Show at least four ties, also fence lines, roads, topo, size and type of witness trees' and if off road - best way to arrive at corner.

Ties are to nail and disc.

MAINTENANCE RECORD

Date	Init.	Remarks		
11-27-78	RN-DA	OK		
3-10-83	GR-SS	OK		
10/5/92	JG	OK		
2-13-98	JG	2-GONE 1-NEW, MONIOR		
SEE ATTAC	HED ST	WET GROHOLSKI, 1/21/00		
1-24-03	JG	OK		

