SECTION

19 TOWN

TYPE OF MONUMENT:

FIELD WORK DATE:

OB ADAMS COUNTY

COUNTY CORNER NO: 73

ROMPORTOL ID: 41906130000

PUBLIC LAND SURVEY MONUMENT RECORD

HARRISON (BROKEN-TOP)

N 271820.821	
E. <u>557172.484</u>	
ELEVATION D	ATUM


01/23/2018

BASIS FOR MONUMENT LOCATION

ADAMS COUNTY COORDINATES, NAD 83 (2007)

1977 - PLS 1103 RAN EDM/T2 TRAVERSE AROUND SECTION 24 AND MANY ADJACENT SECTIONS TO DETERMINE THE SEARCH AREA FOR INVESTIGATION. THE SEARCH AREA FALLS WITHIN A CUT-SECTION OF A DITCH, SO NO EXCAVATION WAS DONE AT THAT LOCATION. ANTHONY KIEDROWSKI, COUNTY SURVEYOR, DID EXCAVATE AT THE CENTERLINE OF COUNTY TRUNK C TO CONFIRM THAT THE ROAD WAS NOT BUILT ON A SECTION LINE, BUT NOTHING WAS FOUND. ESTABLISHED THE CORNER BY SINGLE PROPORTIONATE MEASUREMENT BETWEEN THE SW CORNER OF SECTION 31-19-17 AND THE NW CORNER OF SECTION 18-19-7, WITH A PI AT THIS CONFIRM THAT THE ROAD WAS NOT BUILT ON THE NW CORNER OF SECTION 18-19-7, WITH A PI AT THIS CONFIRM THAT THE ROAD WAS NOT BUILT ON THE NW CORNER OF SECTION 18-19-7, WITH A PI AT THIS CONFIRM THAT THE PANEL CORNER IN ORDER TO MATCH THE ONLY SUBSTANTIAL OCCUPATION ALONG THE RANGE LINE. SET A HARRISON MONUMENT AND TIED OUT.

2018 - PLS 2994 FOUND A HARRISON MONUMENT WITH A BROKEN-TOP 6" BELOW THE GROUND SURFACE AND 2 TIES. THE MONUMENT AGREES WITH THE EXISTING TIES. ACCEPTED THE HARRISON MONUMENT WITH A BROKEN-TOP AS THE CORNER LOCATION. SET 2 NEW TIES AND MEASURED TO THE TIES.

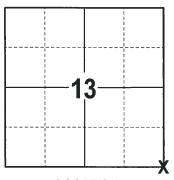

LOCATION (INDICATE CORNER BY "X")

SEAL: CONS TIMOTHY G. RUTZEN, JR. S-2994 MOSINEE.

DATA SHOWN HERE ON THIS TIE SHEET IS CORRECT AND COMPLETE TO THE BEST OF MY KNOWLEDGE AND BELIEF.

PROFESSIONAL LAND SURVEYOR


3-1-18 DATE

- TIE SKETCH

NOTE: THE CORNER FALLS 32'± SOUTH OF THE CENTERLINE OF CTH C AND 3'± WEST OF THE CENTERLINE OF 7TH AVE.



- 3/4" x 18" IRON REBAR SET, 1.50#/FT
- 3/4" IRON ROD FOUND
- 🕀 HARRISON (BROKEN-TOP) FOUND
- RIGHT-OF-WAY GUARD POST
- → VINYL "T" POST

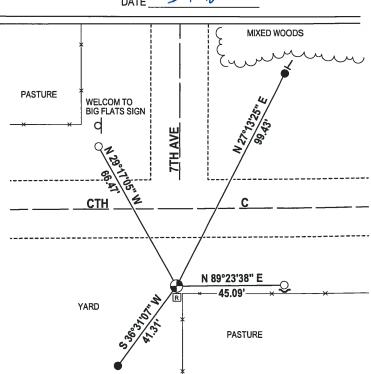

Government Land Corner Certificate

ADAMS	_County
TYPE OF MONUMENT: HARRISON	Sro.
STATE PLANE COORDINATES: N	·
E	
ELEVATION — M.S.L. DATUM:	
THETA ANGLE:	<u> </u>
FIELD BOOK:	PAGE
DRAWN BY: Scott SORENS	SEN

BASIS FOR MONUMENT LOCATION


Show info such as: History of corner, with reference to Vol. and pg., dates, surveyor; exact description of monument replaced; if location computed, by taped or EDM traverse; landowner remarks, etc. (Use reverse side if necessary)

Ran EDM/T2 traverse around Section 24 and many adjacent sections to determine search area for investigation.


Search area falls within cut-section of ditch, sonno excavation was done at that location. Anthony Kiedrowski, County Surveyor, did excavate at centerline of County Trunk'C' to confirm that Road was not built on section line, but nothing was found.

Relocated corner by single proportionate measure between SW of 31-19-7 and NW of 18-19-7, with PI at this corner in order to match the only substantial occupation along the range line.

Monument set 9-8-1977.

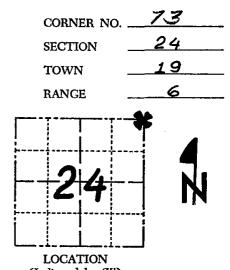

SEAL:

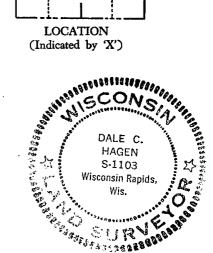

DATA SHOWN HERE ON CERTIFIED CORRECT:

Registered Land Surveyor

DATE: December 27, 1977

TIE SKETCH

Show at least four ties, also fence lines, roads, topo, size and type of witness trees' and if off road - best way to arrive at corner.

NOTE

Ties in trees to nail in disc.

'08 3/4" POD SET 45.0' EAST OF HARRISON TO. 3' N. of FENCE POST

MAINTENANCE RECORD

Date	Init.	Remarks
11-27-78	RN-DA	ok
<u>3-10-83</u>	GR-SS	OK
	56	1-TILE GONE 1-NEW TIE
2-13-98	JG	OK
1-24.03	JZ_	OK_
8-13-08	KS-55	3 NEW TIES

