# 06 RANGE ADAMS COUNTY COUNTY COUNTY CORNER NO: 78 ROMPORTOL ID: 41906222000

## PUBLIC LAND SURVEY MONUMENT RECORD

**HARRISON** TYPE OF MONUMENT: ADAMS COUNTY COORDINATES, NAD 83 (2007) N. 269130.346 E. 546592.841 DATUM


12/10/2018

#### **BASIS FOR MONUMENT LOCATION**

FIELD WORK DATE:\_

1971 - PLS 981 FOUND A IRON PIPE AND RESET THE CORNER WITH A HARRISON MONUMENT IN PLACE OF THE IRON PIPE. TIED OUT CORNER.

2018 - PLS 2675 FOUND A HARRISON MONUMENT 6" BELOW THE GROUND SURFACE. DID NOT RECOVER ANY OF THE EXISTING TIES OR WITNESSES, BELIEVED ALL TO BE DESTROYED DUE TO FIRE. ACCEPTED THE HARRISON MONUMENT AS THE BEST EVIDENCE OF THE CORNER LOCATION. SET 4 NEW TIES AND MEASURED TO THE

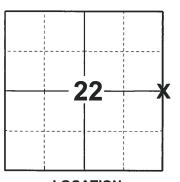

LOCATION (INDICATE CORNER BY "X")



DATA SHOWN HERE ON THIS TIE SHEET IS CORRECT AND COMPLETE TO THE BEST OF MY KNOWLEDGE AND BELIEF.


PROFESSIONAL LAND SURVEYOR

1-18-19

#### -TIE SKETCH

NOTE: THE CORNER FALLS 16'± EAST OF THE CENTERLINE OF 9TH AVE.



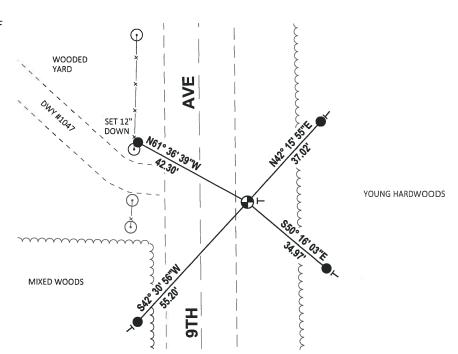

SET 3/4" x 18" IRON REBAR, 1.50#/FT

FOUND HARRISON MONUMENT

→ VINYL "T" POST

78	)
(0)	1

35

22

4 -			-~	~ ~				_
AD	Α	IV	1S	C	)(	JN	ויוי	7

### Survey Monument Record

TYPE OF MONUMENT: 30" HARRISON


STATE PLANE COORDINATES: N\_\_\_\_

F\_\_\_\_

ELEVATION — M.S.L. DATUM:

THETA ANGLE:

FIELD BOOK: 104 PAGE 68

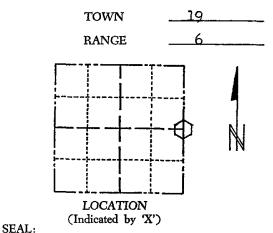

CORNER NO. \_

**SECTION** 

#### BASIS FOR MONUMENT LOCATION

(Use reverse side if necessary)

Show info such as: History of corner, with reference to Vol. and pg, dates, surveyor; exact description of monument replaced; if location computed, by taped or EDM traverse; landowner remarks, etc.

Found iron pipe and set monument

August 12, 1971

Sam T. Mullen R.L.S. S-981

OK 11-28-78 RN-DA 3-10-83 GR-SS OK OK-10/5/92-JG OK, 2-13-98-JG OK, 1-24-03-JG

CERTIFIED CORRECT:

Registered Land Surveyor

DATE: -

## TIE SKETCH 2-0840, 12-17-07- J6-55

(Show at least four ties)

