06 RANGE ADAMS COUNTY C

PUBLIC LAND SURVEY MONUMENT RECORD

HARRISON TYPE OF MONUMENT: ADAMS COUNTY COORDINATES, NAD 83 (2007) N. **269172.623**

ELEVATION- - - -DATUM


FIELD WORK DATE: 12/10/2018

E. 551888.324

BASIS FOR MONUMENT LOCATION

1977 - PLS 878 FOUND REMAINS OF 4" CHARCOALED STAKE DOWN INTO SUBSOIL AT LEAST 12" DURING EXCAVATION WITH BACKHOE IN SEARCH AREA THAT WAS DETERMINED AFTER ANALYSIS OF EXTENSIVE TRAVERSE OF SURROUNDING SECTIONS. RE-MONUMENTED POST WITH STANDARD HARRISON MONUMENT.

2018 - PLS 2675 FOUND A HARRISON MONUMENT 4" BELOW THE ROAD SURFACE AND 2 TIES. THE MONUMENT AGREES WITH THE EXISTING TIES, ACCEPTED THE HARRISON MONUMENT AS THE CORNER LOCATION. SET 2 NEW TIES AND MEASURED TO THE TIES.

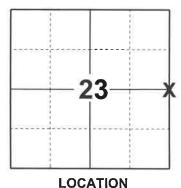

(INDICATE CORNER BY "X")



DATA SHOWN HERE ON THIS TIE SHEET IS CORRECT AND COMPLETE TO THE BEST OF MY KNOWLEDGE AND BELIEF.

PROFESSIONAL LAND SURVEYOR

DATE

- TIE SKETCH -

NOTE: THE CORNER FALLS 2'± EAST OF THE CENTERLINE OF 8TH AVE.




YOUNG PINE PLANTATION

- FOUND 3/4" IRON ROD
- FOUND HARRISON MONUMENT

SET 3/4" x 18" IRON REBAR, 1.50#/FT

VINYL "T" POST

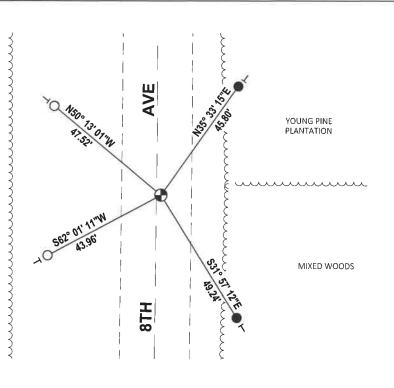

CORNER NO. ADAMS COUNTY SECTION Survey Monument Record TOWN TYPE OF MONUMENT: HARRISON STANDARD RANGE STATE PLANE COORDINATES: N_ ELEVATION - M.S.L. DATUM: _ THETA ANGLE: ___ 54 PAGE /2 FIELD BOOK: _____ BASIS FOR MONUMENT LOCATION (Use reverse side if necessary) Show info such as: History of corner, with reference to Vol. and pg, dates, surveyor; exact description of monument replaced; if location computed, by taped or EDM traverse; landowner remarks, etc. LOCATION (Indicated by 'X') SEAL: Found remains of 4" charcoaled stake down into subsoil at least 12" during excavation with backhoe in search area that was determined after analysis of ANTHONY B. extensive traverse of surrounding sections. 6-28-77 KIEDROWSKI S-878 Monumented post with standard Harrison Wisconsin Rapids, monument. OK 11-27-78 RN-DA GR-SS 3-10-83 01 CERTIFIED CORRECT: OK - 10/5/92-JG ReonyBVc. OK, 2-13-98-JG DATE: 9/C/27 2-60NE, 2-NEW, MON. OK, 1-28-03-JG 2 NEW TIES 8-13-08 TIE SKETCH (Show at least four ties) GOVE BEARING TREES WEST ARE DESTRUYED SET 3/4" ROD 47.55' NW-100 (d) 6"8/ack Oak/gr

IN W. of OHE