ADAMS COUNTY COUNTY COUNTY CORNER NO: 82

ROMPORTOL ID: 41906190020

PUBLIC LAND SURVEY MONUMENT RECORD

HARRISON TYPE OF MONUMENT: ADAMS COUNTY COORDINATES, NAD 83 (2007) N. 266390.345

E. 528067.458


DATUM_

12/11/2018 FIELD WORK DATE:


BASIS FOR MONUMENT LOCATION

1973 - PLS 878 EXCAVATED WITH A BACKHOE AND FOUND A 2"X30" IRON PIPE. SET HARRISON MONUMENT AND TIED OUT.

2018 - PLS 2675 FOUND A HARRISON MONUMENT 3" BELOW THE ROAD SURFACE, 1 TIE AND 1 WITNESS. THE MONUMENT AGREES WITH THE EXISTING TIE AND WITNESS. ACCEPTED THE HARRISON MONUMENT AS THE CORNER LOCATION. SET 3 NEW TIES AND MEASURED TO THE TIES AND WITNESS.

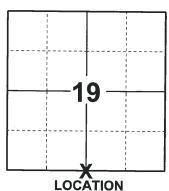

(INDICATE CORNER BY "X")

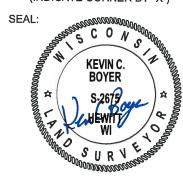

DATA SHOWN HERE ON THIS TIE SHEET IS CORRECT AND COMPLETE TO THE BEST OF MY KNOWLEDGE AND BELIEF.

PROFESSIONAL LAND SURVEYOR


DATE 1-18-19

-TIE SKETCH

NOTE: THE CORNER FALLS 1'± SOUTH OF THE CENTERLINE OF BROWNDEER AVE.

- SET 3/4" x 18" IRON REBAR, 1.50#/FT
- FOUND 1" O.D. IRON PIPE
- FOUND HARRISON MONUMENT
- VINYL "T" POST
- STEEL FENCE POST

MIXED WOODS

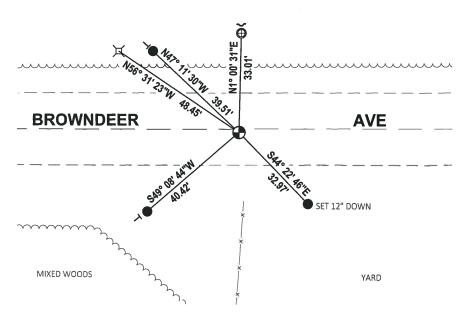

ADAMS COUNTY

Survey Monument Record

TYPE OF MONUMENT: <u>30" HIGRRISON</u>

STATE PLANE COORDINATES: N____

E_____

ELEVATION — M.S.L. DATUM: ____

THETA ANGLE:

FIELD BOOK: 108 PAGE 58

BASIS FOR MONUMENT LOCATION

(Use reverse side if necessary)

Show info such as: History of corner, with reference to Vol. and pg, dates, surveyor; exact description of monument replaced; if location computed, by taped or EDM traverse; landowner remarks, etc.

Exca vated with backhoe. Found 2" x 30" iron pipe. Monumented same.

OK 11-27-78 RN-DA 3-11-83 GR-SS OK 1-GONE, 2-NEW TIES 1-4-93 B5-JG

1-GONE 1-NEW, 2-11-98-JG 1-NEW-MONDK, 12-12-02-JG 1-GONE, 12-21-07-JG-SS TOWN
RANGE

LOCATION
(Indicated by 'X')

CORNER NO. _296

SECTION

SEAL:



CERTIFIED CORRECT:

Registered Land Surveyor

DATE: 9/18/73

TIE SKETCH

(Show at least four ties)

