SECTION

TOWN

ADAMS COUNTY COUNTY COUNTY CORNER NO: 83 ROMPORTOL ID: 41906190000

PUBLIC LAND SURVEY MONUMENT RECORD

HARRISON (BROKEN-TOP) TYPE OF MONUMENT: ADAMS COUNTY COORDINATES, NAD 83 (2007) N. 266435.753 E. 530773.766 **ELEVATION-**DATUM 12/11/2018 FIELD WORK DATE:_


BASIS FOR MONUMENT LOCATION

1971- PLS 981 SET A HARRISON MONUMENT AND TIED OUT.

2018 - PLS 2675 FOUND A HARRISON MONUMENT WITH A BROKEN-TOP 6" BELOW THE ROAD SURFACE, 1 PROPERTY IRON AND 1 WITNESS. THE MONUMENT AGREES WITH THE EXISTING WITNESS. ACCEPTED THE HARRISON MONUMENT WITH A BROKEN-TOP AS THE CORNER LOCATION. SET 4 NEW TIES AND MEASURED MEASURED TO THE TIES, PROPERTY IRON AND WITNESS.



(INDICATE CORNER BY "X")

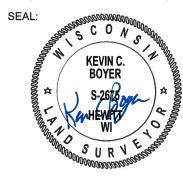

DATA SHOWN HERE ON THIS TIE SHEET IS CORRECT AND COMPLETE TO THE BEST OF MY KNOWLEDGE AND BELIEF.

PROFESSIONAL LAND SURVEYOR


1-18-19

-TIE SKETCH

NOTE: THE CORNER FALLS 1'± EAST OF THE CENTERLINE OF 13TH AVE.



- SET 3/4" x 18" IRON REBAR, 1.50#/FT
- FOUND 1" O.D. IRON PIPE
- FOUND HARRISON MONUMENT (BROKEN-TOP)
- VINYL "T" POST
- 4" WHITE PINE TREE

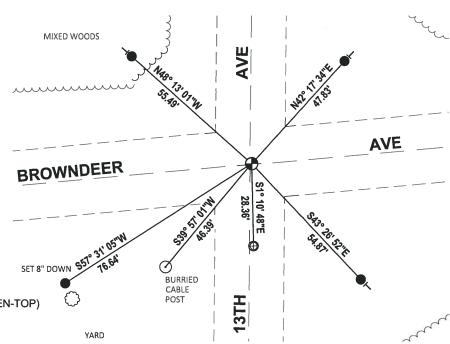

ADAMS COUNTY

Survey Monument Record


TYPE OF MONUMENT: 30" HARRISON
STATE PLANE COORDINATES: N______

E_____

ELEVATION — M.S.L. DATUM: ____

THETA ANGLE:

FIELD BOOK: 104 PAGE 81

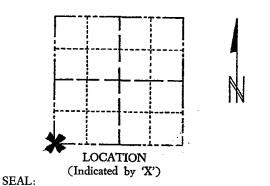

CORNER NO. .

SECTION

TOWN

RANGE

50

20

BASIS FOR MONUMENT LOCATION

(Use reverse side if necessary)

Show info such as: History of corner, with reference to Vol. and pg, dates, surveyor; exact description of monument replaced; if location computed, by taped or EDM traverse; landowner remarks, etc.

Set monument

September 2, 1971

Sam T. Mullen R.L.S. S-981

OK 11-27-78 RN-DA 3-11-83 GR-SS SK OK - 1-4-93 BS-JG OK, 2-11-98-JG 1-GONE Z-NEW TOP BROKEN OFF MON., 12-12-02-JG OK, 12-20-07-JG-SS

CERTIFIED CORRECT:

Registered Land Surveyor
DATE:

TIE SKETCH

(Show at least four ties)

