23 SECTION

19

ADAMS COUNTY COUNTY COUNTY CORNER NO: 91 ROMPORTOL ID: 41906230000

PUBLIC LAND SURVEY MONUMENT RECORD

HARRISON TYPE OF MONUMENT: ADAMS COUNTY COORDINATES, NAD 83 (2007) N. 266532.569 E. 551876.611


DATUM

12/10/2018 FIELD WORK DATE:_


BASIS FOR MONUMENT LOCATION

1977 - PLS 1103 RAN EDM TRAVERSE AROUND SECTION 24 AND MANY ADJOINING SECTIONS TO DETERMINE SEARCH AREA FOR INVESTIGATION. EXCAVATION WITH BACKHOE BY ANTHONY KIEDROWSKI, ADAMS COUNTY SURVEYOR, YIELDED NO EVIDENCE OF THE ORIGINAL CORNER OR ANY REMONUMENTATION. COULD NOT FIND NO BEARING TREES. RELOCATED CORNER BY DOUBLE PROPORTIONATE MEASURE BETWEEN W OF 23, SE OF 23, NW OF 26, AND E OF 26. HARRISON MONUMENT SET.

2018 - PLS 2675 FOUND A HARRISON MONUMENT 4" BELOW THE ROAD SURFACE. FOUND NO EVIDENCE OF ANY OF THE EXISTING TIES OR WITNESSES. ACCEPTED THE HARRISON MONUMENT AS THE BEST EVIDENCE OF THE CORNER LOCATION. SET 4 NEW TIES AND MEASURED TO THE TIES.

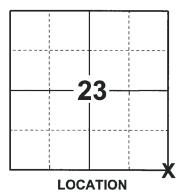

(INDICATE CORNER BY "X")

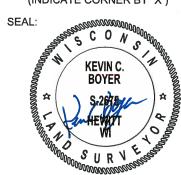

DATA SHOWN HERE ON THIS TIE SHEET IS CORRECT AND COMPLETE TO THE BEST OF MY KNOWLEDGE AND BELIEF.


PROFESSIONAL LAND SURVEYOR

-TIE SKETCH

NOTE: THE CORNER FALLS 4'± EAST OF THE CENTERLINE OF 8TH AVE.



- SET 3/4" x 18" IRON REBAR, 1.50#/FT
- FOUND HARRISON MONUMENT
- VINYL "T" POST

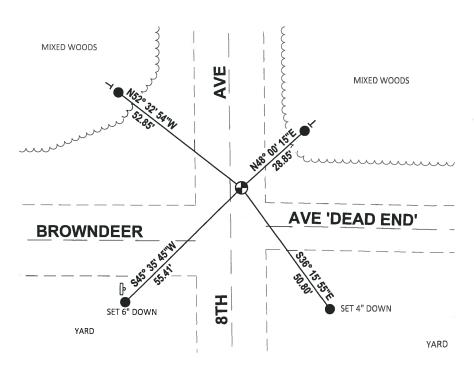

Government Land Corner Certificate

ADAMS	Coun	ty
TYPE OF MONUMENT: HARR.		•
STATE PLANE COORDINATES:	N	
	E	· · · · · · · · · · · · · · · · · · ·
ELEVATION — M.S.L. DATUM:	: <u></u> -	
THETA ANGLE:		
FIELD BOOK: 54		
DRAWN BY: Scott SORE	NSEN	

BASIS FOR MONUMENT LOCATION


Show info such as: History of corner, with reference to Vol. and pg., dates, surveyor; exact description of monument replaced; if location computed, by taped or EDM traverse; landowner remarks, etc. (Use reverse side if necessary)


Ran EDM/T2 traverse around Section 24 and many adjoining sections to determine search area for investigation.

Excavation with backnoe by Anthony Kiedrowski, Adams County Surveyor, yielded no evidence of the original corner or any remonumentation. Could find no bearing treex.

Relocated corner by double porportionate measure between W/4 of 23, SE of 23, NW of 26, and E% of 26.

Monument set 9-8-1977.

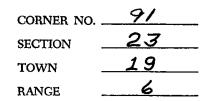

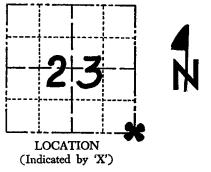

SEAL:

S-1103 Wisconsin Rapids, Wis.

DATA SHOWN HERE ON CERTIFIED CORRECT:

Registered Land Surveyor

12**-**27**-**19**77** DATE:

TIE SKETCH

Show at least four ties, also fence lines, roads, topo, size and type of witness trees' and if off road - best way to arrive at corner.

Ties in trees to nail in disc.

MAINTENANCE RECORD

Date Init.		Remarks	
11-27-78 RN-DA	Ot		
3-10-83	GR-55	_or	
10/5/92	JG	OK	
1-13-98	56	OK	
1-28-03	56	OK	,
12-17-07	TG-55	OK	

