24 SECTION

### 06 RANGE ADAMS COUNTY COUNTY COUNTY CORNER NO: 92 ROMPORTOL ID: 41906240020

#### PUBLIC LAND SURVEY MONUMENT RECORD

**HARRISON (BROKEN-TOP)** TYPE OF MONUMENT: ADAMS COUNTY COORDINATES, NAD 83 (2007) N. 266536.157 E. 554535.865 ELEVATION-\_\_ - \_\_\_ DATUM\_\_


12/05/2018

FIELD WORK DATE:\_\_\_


#### **BASIS FOR MONUMENT LOCATION**

1977 - PLS 1103 RAN EDM TRAVERSE AROUND SECTION 24 AND PARTS OF MANY ADJOINING SECTIONS TO DETERMINE SEARCH AREA FOR INVESTIGATION. COULD FIND NO EVIDENCE OF THE ORIGINAL CORNER OR ANY REMONUMENTATION. COULD FIND NO RECORD OF THE 5" IRON PIPE HAVING BEEN SET AS A SURVEY MONUMENT. RELOCATED CORNER BY SINGLE PROPORTIONATE MEASURE BETWEEN ADJACENT SECTION CORNERS. SET HARRISON MONUMENT.

2018 - PLS 2675 FOUND A HARRISON MONUMENT WITH A BROKEN-TOP 24" BELOW THE ICE AND WATER AND 1 WITNESS. THE MONUMENT AGREES WITH THE EXISTING WITNESS. ACCEPTED THE HARRISON MONUMENT WITH A BROKEN-TOP AS THE CORNER LOCATION. SET 4 NEW TIES AND MEASURED TO THE TIES AND WITNESS.

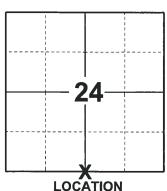

(INDICATE CORNER BY "X")

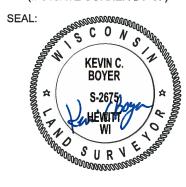


DATA SHOWN HERE ON THIS TIE SHEET IS CORRECT AND COMPLETE TO THE BEST OF MY KNOWLEDGE AND BELIEF.


PROFESSIONAL LAND SURVEYOR

DATE

#### -TIE SKETCH

NOTE: THE CORNER FALLS 9'± NORTH OF THE CENTERLINE OF THE TRAIL.

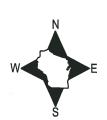

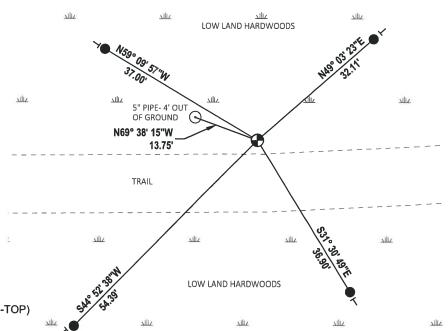


- SET 3/4" x 48" IRON REBAR, 1.50#/FT
  - FOUND HARRISON MONUMENT (BROKEN-TOP)
- VINYL "T" POST

#### **Government Land Corner Certificate**

ADAMS	County
TYPE OF MONUMENT: HARRIS	ON STO.
STATE PLANE COORDINATES: N.	
E.	<del></del>
ELEVATION — M.S.L. DATUM: _	
THETA ANGLE:	
FIELD BOOK: 54	PAGE <i>33</i>
DRAWN BY: _ Scott SOREN	SEN

## CORNER NO. 92 SECTION 24 TOWN 19 RANGE 6

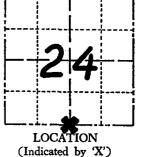



#### BASIS FOR MONUMENT LOCATION

Show info such as: History of corner, with reference to Vol. and pg., dates, surveyor; exact description of monument replaced; if location computed, by taped or EDM traverse; landowner remarks, etc. (Use reverse side if necessary)
Ran EDM/T2 traverse around Section 24 and SEAL: parts of many adjoining sections to determine search area for investigation.

Could find no evidence of the original corner or any remonumentation. Could find no record of the 5" Iron Pipe having been set as a survey monument.

Relocated corner by single proportionate measure between adjacent section corners. Set monument on 9-8-1977.



DATA SHOWN HERE ON CERTIFIED CORRECT:

Registered Land Surveyor

DATE: 12-27-1977

#### TIE SKETCH

Show at least four ties, also fence lines, roads, topo, size and type of witness trees' and if off road - best way to arrive at corner.

#### NOTE

Ties in trees to nail in disc.

# B'BLACK CARY S''PIDE-4' OUT OF GROUND DOST TRAIL CONT. FAST OF 11'S OROWNDERR AVE.

#### MAINTENANCE RECORD

Date	Init.	Remarks	
11-27-78	PU-DA	OK	
3-10-83	GR-SS.	OK	
1-8-93	JG-BS	1-GONE, 1-NEW TIE	
2-13-48	JG	OK	
-28-03	JG	OK	
2-17-07	16-SS	ok	