29 SECTION

19 TOWN

ADAMS COUNTY COU

PUBLIC LAND SURVEY MONUMENT RECORD

HARRISON TYPE OF MONUMENT: ADAMS COUNTY COORDINATES, NAD 83 (2007)

N. **263846.437**

E. 536079.861


DATUM

12/14/2018 FIELD WORK DATE:

BASIS FOR MONUMENT LOCATION

1980 - PLS 878 EXCAVATED A 6' STRIP ALL THE WAY ACROSS THE ROAD, AT THE HALF WAY DISTANCE BETWEEN SECTION CORNERS. ALSO EXCAVATED AN 8' X 12' AREA FURTHER NORTH OPPOSITE EVIDENCE OF AN OLD TREE LINE TO THE WEST, FOUND A 3/4" X 24" REBAR IN THE FIRST HOLE. FOUND A SPIKE AT THE CENTERLINE AND A SPIKE/TAB AT HALF WAY AND ON LINE BETWEEN SECTION CORNERS. MONUMENTED THE SPIKE FOUND AT THE CENTERLINE BECAUSE IT IS VERY NEARLY HALF WAY, AND BECAUSE IT WAS 33.00' EAST OF A 3/4" IRON PIPE SET IN THE CORNER OF A RELATIVELY NEW FENCE. (5 - 10 YEARS OLD) WAS UNABLE TO DETERMINE WHO PUT THE PIPE THERE. SET A HARRISON MONUMENT AND TIED OUT.

2018 - PLS 2675 FOUND A HARRISON MONUMENT 4" BELOW THE ROAD SURFACE, 1 TIE AND 1 PROPERTY IRON. THE MONUMENT AGREES WITH THE EXISTING TIE. ACCEPTED THE HARRISON MONUMENT AS THE CORNER LOCATION. SET 2 NEW TIES AND MEASURED TO THE TIES AND PROPERTY IRON.

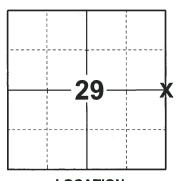

LOCATION

(INDICATE CORNER BY "X")



DATA SHOWN HERE ON THIS TIE SHEET IS CORRECT AND COMPLETE TO THE BEST OF MY KNOWLEDGE AND BELIEF.

PROFESSIONAL LAND SURVEYOR


1-18-19

-TIE SKETCH

NOTE: THE CORNER FALLS 2'± WEST OF THE CENTERLINE OF 11TH AVE.



- SET 3/4" x 18" IRON REBAR, 1.50#/FT
- FOUND 3/4" IRON ROD
- FOUND 1" O.D. IRON PIPE
- **FOUND HARRISON MONUMENT**
- STEEL FENCE POST
- VINYL "T" POST

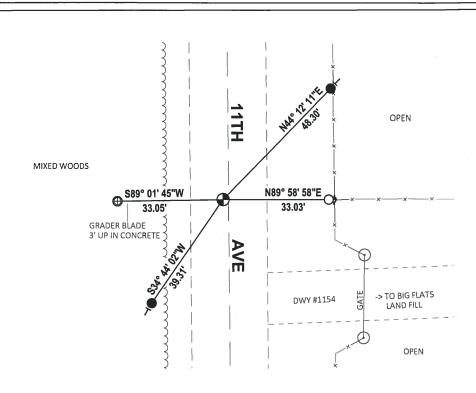

SET MAR. 4/22/80-RAVES **Government Land Corner Certificate** 96 CORNER NO. . REPLACE PIX -lams County SPRING 180 29 SECTION TYPE OF MONUMENT: Harrison Monument 19 **TOWN** STATE PLANE COORDINATES: N. RANGE ELEVATION — M.S.L. DATUM: THETA ANGLE: _ 83/102) PAGE _ FIELD BOOK: _ DRAWN BY: Gree Rhinehart BASIS FOR MONUMENT LOCATION Show info such as: History of corner, with reference to Vol. and pg., dates, surveyor; exact description of monument replaced; if location computed, by taped or EDM traverse; LOCATION landowner remarks, etc. (Use reverse side if necessary) SEAL: Excavated a:6' strip all the way across the road, at the half way distance between section corners. Also excavated an 8 x 12' area further ANTHONY B. north opposite evidence of an old tree line to the **KIEDROWSKI** west. Found a 3/4" x 24" rebar. In the first hole S-878 I found a spike at the centerline and a spike/tab Wisconsin Rapids, at half way and on line between section corners. I monumented the spike found at the centerline because it is very nearly half way, and because it was 33.00' east of a 3/4" iron pipe set in the corner of a relatively new fence. (5- ten years old) Was unable determine who put pipe there. DATA SHOWN HERE ON CERTIFIED CORRECT: Registered Land Surveyor 2/21/80 DATE: COR. TIE SKETCH 79-19-6 Show at least four ties, also fence lines, roads, topo, size 4"BLK OAK and type of witness trees' and if off road - best way to IN CLUSTER OF FOUR arrive at corner. GONG METAL BIG FLATS

SE COF.

MAINTENANCE RECORD

DATE	BY WHOM	REMARKS
3-10-83	GR-55	I BT CONE COR. OK
10/5/92	JG	2-TIES GONE, 2-NEW TIE, MON OK
2-11-98	JG	1-GONE, 1-NEW, MON. OK
10/5/92 2-11-98 12-12-02	JG	1-GONE, 2-NEW, MON. OK
12-17-07	J6-55	OK
		·
<u> </u>		
		, .
. %		
1		