# OB ADAMS COUNTY

COUNTY CORNER NO: 100

ROMPORTOL ID: 41906252000

## PUBLIC LAND SURVEY MONUMENT RECORD

**HARRISON (BROKEN-TOP)** TYPE OF MONUMENT: ADAMS COUNTY COORDINATES, NAD 83 (2007) N. **263898.557** E. 557195.821

DATUM - -

01/29/2018 FIELD WORK DATE:


ELEVATION- - - -

#### BASIS FOR MONUMENT LOCATION

1979 - PLS 1478 SET HARRISON MONUMENT USING SINGLE PROPORTIONATE MEASUREMENT AND ON A LINE BETWEEN ADJACENT SECTION CORNERS AND TIED OUT.

2007 - PLS (UNKNOWN) NOTED 4 WITNESSES GONE AND TOP BROKEN OFF HARRISON, RE-TIED CÒRNER.

2018 - PLS 2994 FOUND A HARRISON MONUMENT WITH A BROKEN-TOP 6" BELOW THE GROUND SURFACE. FOUND NO EVIDENCE OF ANY OF THE WITNESSES DUE TO RECENT LOGGING, ACCEPTED THE HARRISON MONUMENT WITH A BROKEN-TOP AS THE BEST EVIDENCE OF THE CORNER LOCATION. SET 4 NEW TIES AND MEASURED TO THE TIES.

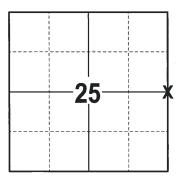

LOCATION (INDICATE CORNER BY "X")

SEAL: CON TIMOTHY G. RUTZEN, JR. S-2994 MOSINE

DATA SHOWN HERE ON THIS TIE SHEET IS CORRECT AND COMPLETE TO THE BEST OF MY KNOWLEDGE AND BELIEF.

PROFESSIONAL LAND SURVEYOR


DATE

#### - TIE SKETCH

NOTE: THE CORNER FALLS 11'± EAST OF THE CENTERLINE OF THE TRAIL.



**OPEN HARDWOODS** (LOGGED)

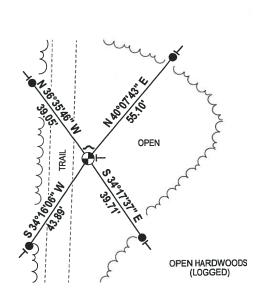

3/4" x 18" IRON REBAR SET, 1.50#/FT THARRISON (BROKEN-TOP) FOUND

→ VINYL "T" POST

### **Government Land Corner Certificate** 100 CORNER NO. County 25 SECTION TYPE OF MONUMENT: HARRISON MONUMENT TOWN STATE PLANE COORDINATES: N. ሬ **RANGE** ELEVATION — M.S.L. DATUM: \_ THETA ANGLE: \_\_ 83 FIELD BOOK: \_ \_ PAGE \_\_\_**Z**3 RHINEHART DRAWN BY: \_\_\_\_ BASIS FOR MONUMENT LOCATION Show info such as: History of corner, with reference to Vol. and pg., dates, surveyor; exact description of monument replaced; if location computed, by taped or EDM traverse; landowner remarks, etc. (Use reverse side if necessary) LOCATION (Indicated by 'X') SEAL: GREGORY P. RHINEHART S-1478 Wisconsin Rapids Wis. AND SUR DATA SHOWN HARE ON CERTIFIED CORRECT: Set single proportionate and on line between adjacent section corners. CERTIFIED CORRECT: Registered Lad Surveyor 12/31 DATE: TIE SKETCH Show at least four ties, also fence lines, roads, topo, size and type of witness trees' and if off road - best way to arrive at corner. r2/t

### MAINTENANCE RECORD

DATE	BY WHOM	REMARKS
FEB. 83	GR-55	OK
1-8-93	Je - BS	OK .
2-24-98	JG-35	ok .
12-17-07	J6-55	4- CONE, 4-NEW, TOP BROKEN OFF MON.
,	-	