SECTION

## ADAMS COUNTY COUNTY COUNTY CORNER NO: 102

ROMPORTOL ID: 41906300020


## PUBLIC LAND SURVEY MONUMENT RECORD

**HARRISON** TYPE OF MONUMENT: ADAMS COUNTY COORDINATES, NAD 83 (2007) N. 261155.965 E. 528210.335 **ELEVATION-**DATUM 12/17/2018 FIELD WORK DATE:


## **BASIS FOR MONUMENT LOCATION**

1979 - PLS 606 TRAVERSED SECTION 31 USING EDM EQUIPMENT. FOUND A 1" IRON PIPE IN PLACE AT THE CENTERLINE OF BUTTERCUP AVE. AN OLD FENCE LINE IS RUNNING SOUTH FROM THE PIPE LOCATION, PIPE FITS IN WITH LAND BEING DIVIDED IN THE SE1/4 OF SECTION 30, DISTANCE FROM THE NW CORNER TO THE N1/4 CORNER IS WITHIN 3.68 FEET OF THE ORIGINAL GOV'T SURVEY DISTANCE. ACCEPTED AS THE TRUE LOCATION OF SAID CORNER, SET A HARRISON MONUMENT AND TIED OUT.

2018 - PLS 2675 FOUND A MAG NAIL IN THE ROAD SURFACE AND 2 TIES. REMOVED THE MAG NAIL AND FOUND A HARRISON MONUMENT 12" BELOW. THE MONUMENT AGREES WITH THE EXISTING TIES. ACCEPTED THE HARRISON MONUMENT AS THE CORNER LOCATION. SET 2 NEW TIES AND MEASURED TO THE TIES.

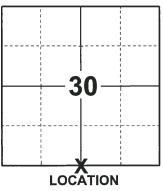

(INDICATE CORNER BY "X")

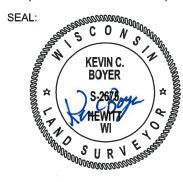

DATA SHOWN HERE ON THIS TIE SHEET IS CORRECT AND COMPLETE TO THE BEST OF MY KNOWLEDGE AND BELIEF.


PROFESSIONAL LAND SURVEYOR

## -TIE SKETCH

NOTE: THE CORNER FALLS 1'± NORTH OF THE CENTERLINE OF BUTTERCUP AVE.



- SET 3/4" x 18" IRON REBAR, 1.50#/FT
- FOUND 3/4" IRON ROD
- FOUND 1-1/2" O.D. IRON PIPE
- FOUND HARRISON MONUMENT
- STEEL FENCE POST
- VINYL "T" POST

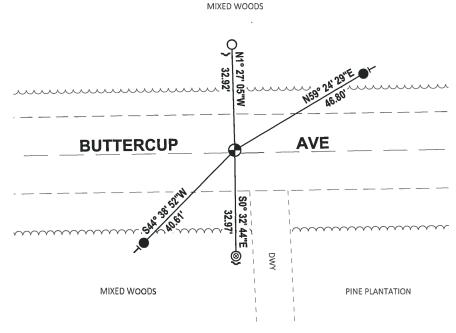

ADAMS	CORNER NO. N 1/4
Survey Monument Record  TYPE OF MONUMENT:	SECTION TOWN RANGE RAGE
ELEVATION — M.S.L. DATUM:  THETA ANGLE: FIELD BOOK: PAGE	A N
BASIS FOR MONUMENT LOCATION	
(Use reverse side if necessary)	
Show info such as: History of corner, with reference to Vol. and pg, dates, surveyor; exact description of monument replaced; if location computed, by taped or EDM traverse; landowner remarks, etc.	LOCATION (Indicated by 'X') SEAL:
Traversed Section 31 using EDM equipement. Found 1" iron pipe in place at the centerline of Buttercup Ave. An old fence line is running south from the pipe location. Pipe fits in with land having been divided in the SE½ of Section 30. Distance from the NW corner to the N½ corner is within 3.68 feet of the original Gov't survey distance. Accepted as the true location of said corne	JAMES J. CARROLL S-606 MAUSTON WIS.
3-11.83 6R-SS OK	SURVE
1-GONE, 2-NEW TIE 1-4-93 JG-BS	•
OK, 2-11-98-JG	CERTIFIED CORRECT:
OK 12-12-02-56 12-21-07 56-55 4 7165 MEMININ	Registered Land Sorregor - 222
, varieties , presentation , present	TE: May 30, 1979
TIE SKETCH	V
(Show at least four ties)	
Jackpine 3/4x2 day 1000	Tackpine N
34.60 E	Aue.

o g'iron pipe

TOP BROKEN OFF/NAU STILL GOOD)