SECTION

TOWN

# ADAMS COUNTY COUNTY CORNER NO: 104

ROMPORTOL ID: 41906290020

## PUBLIC LAND SURVEY MONUMENT RECORD


**SURVEY NAIL** TYPE OF MONUMENT: ADAMS COUNTY COORDINATES, NAD 83 (2007) N. 261200.483 E. 533465.565 DATUM **ELEVATION-**12/17/2018 FIELD WORK DATE:

## BASIS FOR MONUMENT LOCATION


1974 - PLS 417 CALCULATED THE CORNER LOCATION ON STRAIGHT LINES AND EQUIDISTANT BETWEEN SECTION CORNERS ON THE BASIS OF COMPUTED COORDINATES. EXISTING SECTION CORNERS PREVIOUSLY SET. PROBED AND DUG IN GENERAL AREA BUT COULD NOT FIND EVIDENCE OF OLD CORNER. SET A 1/2" BOLT ALUMINUM CAP AND TIED OUT.

2008 - PLS 1452 FOUND A MAG NAIL ON 9-8-2008, PRIOR TO 2008 RESURFACING PROJECT. SET NEW REFERENCE MONUMENTS (4" ALUMINUM DISKS SET IN CONCRETE) ON 10-2-2008. RE-SET SECTION CORNER ON 11-3-2008 AND MEASURED

2018 - PLS 2675 FOUND A SURVEY NAIL IN THE ROAD SURFACE AND 4 TIES. REMOVED THE SURVEY NAIL AND FOUND NO OTHER EVIDENCE OF ANY ADDITIONAL MONUMENTATION BELOW. THE CORNER LOCATION AGREES WITH THE EXISTING TIES AND IS ON A NEAR STRAIGHT LINE AND EQUIDISTANT SPLIT BETWEEN THE SE AND SW CORNERS OF SECTION 29. ACCEPTED THE SURVEY NAIL LOCATION AS THE CORNER LOCATION. RE-MEASURED TO THE EXISTING TIES.

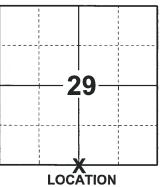

(INDICATE CORNER BY "X")

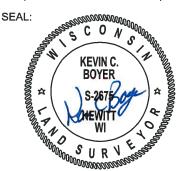


DATA SHOWN HERE ON THIS TIE SHEET IS CORRECT AND COMPLETE TO THE BEST OF MY KNOWLEDGE AND BELIEF.


PROFESSIONAL LAND SURVEYOR

## -TIE SKETCH

NOTE: THE CORNER FALLS 2'± WEST OF THE CENTERLINE OF STH 13 AND 11'± SOUTH OF

THE CENTERLINE OF BUTTERCUP AVE.

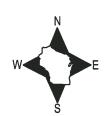

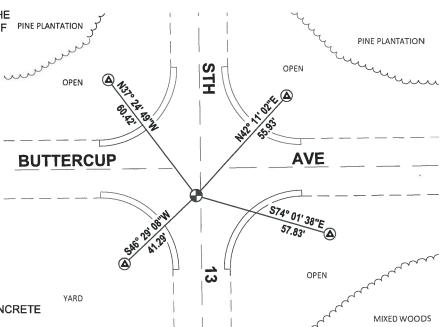

FOUND WISDOT ALUMINUM CAP IN CONCRETE

FOUND SURVEY NAIL

## **ADAMS COUNTY**

## **Survey Monument Record**

TYPE OF MONUM	ENT:	Berntsen Nail	
STATE PLANE CO	ORDINATES: N		_
	E		
ELEVATION - M.	S.L. DATUM:		
THETA ANGLE:			<u> </u>
FIELD BOOK:		PAGE	
DRAWN BY:	D. Christie		

## **BASIS FOR MONUMENT LOCATION**

(Use reverse side if necessary)

Show info such as: History of corner, with reference to Vol. and pg, dates, surveyor, exact description of monument replaced; if location computed, by taped or EDM traverse; landowner remarks, etc.

Found "Mag" nail on 9-8-2008, prior to 2008 Resurfacing Project. Set new reference monuments (4" Alum. Disks set in concrete) on 10-2-2008. Re-set section corner on 11-3-2008 and measured Ties.

SEE RK. SAYER THE SHEET

CORNER NO. 104 32 **SECTION** 19 N TOWN 6 E **RANGE** LOCATION (Indicated by 'X')


SEAL:



12-12-2008 Date:

## TIE SKETCH

(Show at least four ties)

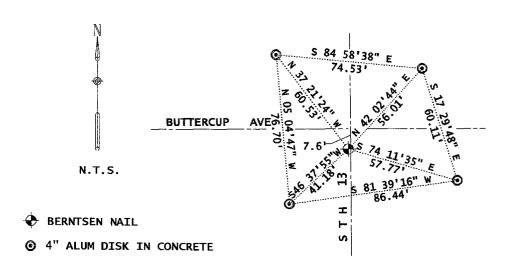

#### CORNER NO. 4 ADAMS COUNTY SECTION Survey Monument Record 19N TOWN 1/2" BOLT ALYMINUM CAP TYPE OF MONUMENT: \_\_\_\_ RANGE STATE PLANE COORDINATES: N\_ F ELEVATION — M.S.L. DATUM: \_\_\_ THETA ANGLE: \_ 28 86 PAGE \_\_\_ FIELD BOOK: \_\_\_\_ BASIS FOR MONUMENT LOCATION (Use reverse side if necessary) LOCATION Show info such as: History of corner, with reference to Vol. and pg, dates, surveyor; exact description of monument replaced; if location computed, by taped or EDM traverse; landowner (Indicated by 'X') SEAL: remarks, etc. SCONS Set on straight lines equidistant between Section corners on the basis R. K. of computed coordinates. Existing SAYLER Section corners previously set. Willingcoone Probed and dug in general area Wit.c: nsin but could not find evidence of old corner. SURVE SEE UPPATE 12-12-08 DENNIS CHRISTIE OK 11-29-78 RN-DA 6R- SS o大 3-11-83 JG-55 CERTIFIED CORRECT: 8-5-97 NEW TIES OK 2-11-98-56 Registered Land Surveyor OK 5-19-03 JG-SS OK- 11-14-07- JG-JS DATE: September TIE SKETCH (Show at least four ties) CORNER MONUNENTED WITH "MAG" NAIL IN TELEPHONE BITUMINOUS ABOVE O P.K. NAIL IN POWER POLE TERMINAL CAP. ALUMINUM O POLE (NAIL) NAIL IS = Z' W. of & "13" & +7'5, ox & BUTTERCUP, EXISTING P.K. NEIL, UNKNOWN BUTTERCUP ORIGIN, 4T E-E 6.63' FROM 11-BOL 6.63 MAG NAIL SET

POWER POLE

NEW

O,,,

28. B

P.K. NAIL

POWER POLE

NORTHEAST COR.

OF CONCRETE

PATIO @ CABIN

TELEPHONE

- (NAIL + BC