

28 SECTION 19 TOWN 06 RANGE

# ADAMS COUNTY

COUNTY CORNER NO: 106  
ROMPORTOL ID: 41906280020

## PUBLIC LAND SURVEY MONUMENT RECORD

TYPE OF MONUMENT: 1-1/4" O.D. IRON PIPE  
ADAMS COUNTY COORDINATES, NAD 83 (2007)

N. 261215.197

E. 538751.948


ELEVATION- - - - DATUM - - - -

FIELD WORK DATE: 12/18/2018

### BASIS FOR MONUMENT LOCATION

1980 - PLS 1478 FOUND NO EVIDENCE OF ANY PREVIOUS MONUMENTATION. NO RECORD OF ANY MONUMENTATION SUBSEQUENT TO THE ORIGINAL WAS FOUND. CALCULATED THE CORNER LOCATION EQUIDISTANT AND ON LINE BETWEEN ADJACENT SECTION CORNERS.


2018 - PLS 2675 FOUND A 1-1/4" O.D. IRON PIPE 4" ABOVE THE GROUND SURFACE AND 2 WITNESS TREES. THE MONUMENT AGREES WITH THE EXISTING WITNESS TREES AND IS ON A NEAR STRAIGHT LINE AND EQUIDISTANCE BETWEEN THE SE AND SW CORNERS OF SECTION 28. ACCEPTED THE 1-1/4" O.D. IRON PIPE AS THE CORNER LOCATION. SET 4 NEW TIES AND MEASURED TO THE TIES AND WITNESS TREES.

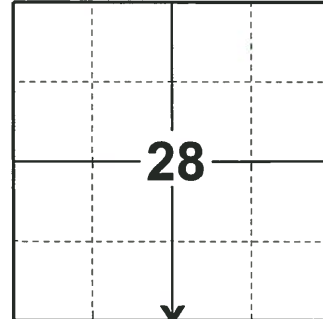

**LOCATION**

(INDICATE CORNER BY "X")

SEAL:


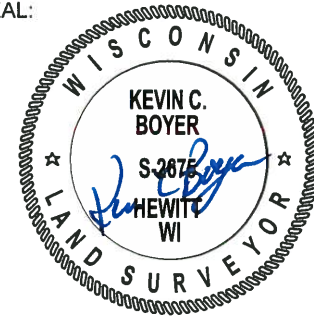


DATA SHOWN HERE ON THIS TIE SHEET IS CORRECT AND COMPLETE TO THE BEST OF MY KNOWLEDGE AND BELIEF.

PROFESSIONAL LAND SURVEYOR

DATE 1-18-19

### -TIE SKETCH-

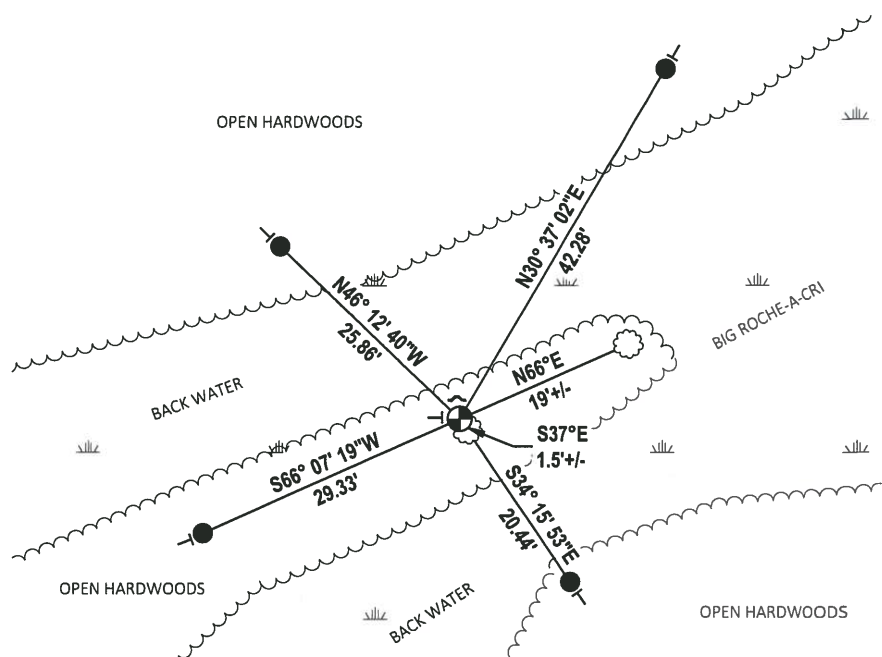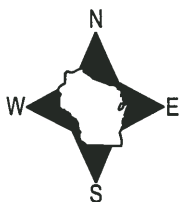


- SET 3/4" x 18" IRON REBAR, 1.50#/FT
- ⊕ FOUND 1-1/4" O.D. IRON PIPE
- ┌ STEEL FENCE POST
- └ VINYL "T" POST
- ⊗ WITNESS TREE

# Government Land Corner Certificate

LEAVE 1" FALLS IN  
ROOTS OF BUR OAK  
MAR/80 RN-5 1126

Adams County  
 TYPE OF MONUMENT: HARRISON STANDARD  
 STATE PLANE COORDINATES: N \_\_\_\_\_  
 E \_\_\_\_\_  
 ELEVATION — M.S.L. DATUM: \_\_\_\_\_  
 THETA ANGLE: \_\_\_\_\_  
 FIELD BOOK: 83 PAGE 64  
 DRAWN BY: G RHINEHART

CORNER NO. 106  
 SECTION 28  
 TOWN 19  
 RANGE 6

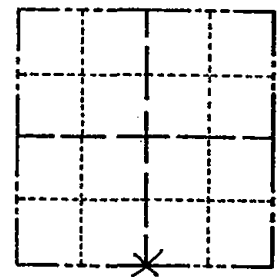

LOCATION  
(Indicated by 'X')

## BASIS FOR MONUMENT LOCATION

Show info such as: History of corner, with reference to Vol. and pg., dates, surveyor; exact description of monument replaced; if location computed, by taped or EDM traverse; landowner remarks, etc. (Use reverse side if necessary)

SEAL:

Set equidistant and on line between Adjacent section corners. No evidence of any previous monumentation was found. No record of any monumentation subsequent to the original was found.



DATA SHOWN HEREON  
 CERTIFIED CORRECT:-  
*Gregory P. Rhinehart*  
 Registered Land Surveyor  
 DATE: 1/21/80

## TIE SKETCH

Show at least four ties, also fence lines, roads, topo, size and type of witness trees and if off road - best way to arrive at corner.

