SECTION

06 ADAMS COUNTY COUNTY CORNER NO: 107

PUBLIC LAND SURVEY MONUMENT RECORD

HARRISON TYPE OF MONUMENT: ADAMS COUNTY COORDINATES, NAD 83 (2007) N. 261209.330 E. 541391.642 ELEVATION-DATUM FIELD WORK DATE:_ 12/14/2018


BASIS FOR MONUMENT LOCATION

1973 - PLS 878 EXCAVATED THE AREA WITH A BACKHOE AND FOUND NOTHING. CALCULATED THE CORNER LOCATION BY TRAVERSE OF ALL OF SECTION AND A MILE TO THE SOUTH, COMPARING WITH ORIGINAL NOTES AND POSSESSION LINES, SET A HARRISON MONUMENT AT THE CALCULATED LOCATION AND TIED OUT.

2018 - PLS 2675 FOUND A MAG NAIL IN THE ROAD SURFACE, 1 PROPERTY IRON AND 1 WITNESS, REMOVED THE MAG NAIL AND FOUND A HARRISON MONUMENT 8" BELOW. THE MONUMENT AGREES WITH THE EXISTING WITNESS, ACCEPTED THE HARRISON MONUMENT AS THE CORNER LOCATION, SET 3 NEW TIES AND MEASURED TO THE TIES, PROPERTY IRON AND WITNESS.



(INDICATE CORNER BY "X")

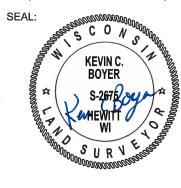

DATA SHOWN HERE ON THIS TIE SHEET IS CORRECT AND COMPLETE TO THE BEST OF MY KNOWLEDGE AND BELIEF.


PROFESSIONAL LAND SURVEYOR

-TIE SKETCH

NOTE: THE CORNER FALLS 3'± SOUTH OF THE CENTERLINE OF BUTTERCUP AVE AND 4'± WEST OF THE CENTERLINE OF 10TH AVE EXTENDED.



- SET 3/4" x 18" IRON REBAR, 1,50#/FT
- FOUND 1-1/4" O.D. IRON PIPE
- FOUND HARRISON MONUMENT
- VINYL "T" POST

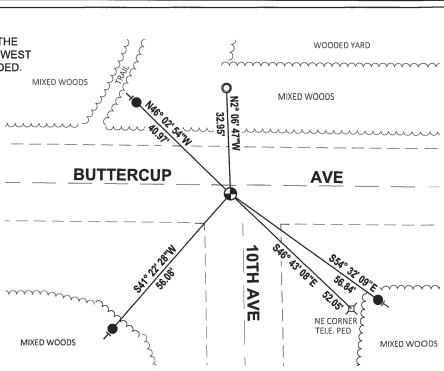

ADAMS COUNTY CORNER NO. _ SECTION Survey Monument Record TYPE OF MONUMENT: Harrison standard TOWN STATE PLANE COORDINATES: N_ RANGE ELEVATION - M.S.L. DATUM: _ THETA ANGLE: . 108 42 FIELD BOOK: ____ BASIS FOR MONUMENT LOCATION (Use reverse side if necessary) Show info such as: History of corner, with reference to Vol. and pg, dates, surveyor; exact description of monument replaced; if location computed, by taped or EDM traverse; landowner LOCATION SEAL: Excavated area with backhoe, found nothing. Point determined by traverse of all of section and a mile to the south, comparing with original notes and posession lines. OK 11-21-78 PN-55 GR-55 3-10-83 N 520 CERTIFIED CORRECT: 8-19-92 ZC-132 - OK 2-13-98-56- OK 2-40NE, 3-NEW, 1-6-03-56 DK, 12-17-07-56.53 DATE: . TIE SKETCH (Show at least four ties) Ties are to nail and disc. NO BT JACKPINE/BT BLK OAK 52.051

NE COR TELE. CABLE BOX

O STREET SIGN