# ADAMS COUNTY COUNTY COUNTY CORNER NO: 115 ROMPORTOL ID: 41906312000

# PUBLIC LAND SURVEY MONUMENT RECORD

**HARRISON** TYPE OF MONUMENT: ADAMS COUNTY COORDINATES, NAD 83 (2007)

N. 258542.767

E. 530870.521


ELEVATION-DATUM

12/17/2018 FIELD WORK DATE:


#### BASIS FOR MONUMENT LOCATION

1974 - PLS 417 CALCULATED THE CORNER LOCATION ON STRAIGHT LINES EQUIDISTANT BETWEEN PREVIOUSLY SET SECTION CORNERS, PROBED AND DUG IN THE GENERAL AREA AND FOUND NO EVIDENCE OF THE OLD CORNER, SET A HARRISON MONUMENT AT THE CALCULATED LOCATION AND TIED OUT.

2018 - PLS 2675 FOUND A HARRISON MONUMENT FLUSH WITH THE GROUND SURFACE AND 2 WITNESSES. THE MONUMENT AGREES WITH THE EXISTING WITNESSES. ACCEPTED THE HARRISON MONUMENT AS THE CORNER LOCATION. SET 4 NEW TIES AND MEASURED TO THE TIES AND WITNESSES.

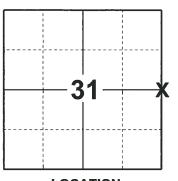

**LOCATION** (INDICATE CORNER BY "X")

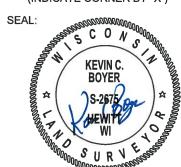

DATA SHOWN HERE ON THIS TIE SHEET IS CORRECT AND COMPLETE TO THE BEST OF MY KNOWLEDGE AND BELIEF.

PROFESSIONAL LAND SURVEYOR


DATE

#### -TIE SKETCH

NOTE: THE CORNER FALLS 1'± SOUTH OF THE FENCE.




- SET 3/4" x 18" IRON REBAR, 1.50#/FT
- FOUND HARRISON MONUMENT
- VINYL "T" POST
- MITNESS TREE STUMP

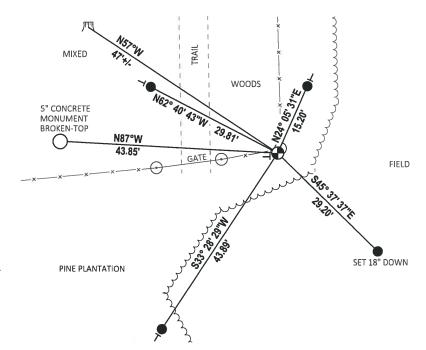

### ADAMS COUNTY

## Survey Monument Record

TYPE OF MONUMENT: HARRISON STATE PLANE COORDINATES: N. ELEVATION - M.S.L. DATUM: THETA ANGLE: \_\_ 28 \_ PAGE \_\_\_86 FIELD BOOK: \_\_\_\_\_

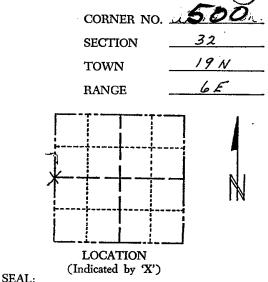

#### BASIS FOR MONUMENT LOCATION

(Use reverse side if necessary)

Show info such as: History of corner, with reference to Vol. and pg, dates, surveyor; exact description of monument replaced; if location computed, by taped or EDM traverse; landowner remarks, etc.

Set on straight lines equidistant between previously set section corners. Probed and dug in general area, could not find evidence of old corner.



OK 11-29-78 RN-DA GR-55 3.29-83 ALL OK, 2-23-98-56 1-NEW, MON, OK 12-12-02-56 OK, 12-21-07- JG

CERTIFIED CORRECT: DATE: Septemb

TIE SKETCH

" 27" (Show at least four ties) JACK PINE NO BT. "CORNER POST S" CONCRETE, MONUMENT (USED FOR LOT (DNB SIGN) (TOP BROKEN) LINE)