SECTION

O6 RANGE ADAMS COUNTY CORNER NO: 117 ROMPORTOL ID: 41906332000

PUBLIC LAND SURVEY MONUMENT RECORD

TYPE OF MONUMENT: ADAMS COUNTY COORDINATES, NAD 83 (2007)

N. **258579.227**

E. 541373.423


ELEVATION-DATUM - ----

FIELD WORK DATE: 12/18/2018


BASIS FOR MONUMENT LOCATION

1973 - PLS 878 CALCULATED THE CORNER LOCATION ON A STRAIGHT LINE EQUIDISTANT BETWEEN SECTION CORNERS. SET A HARRISON MONUMENT AT THE CALCULATED LOCATION AND TIED OUT.

2018 - PLS 2675 FOUND A MAG NAIL IN THE ROAD SURFACE, 1 TIE AND 1 WITNESS TREE. REMOVED THE MAG NAIL AND FOUND A HARRISON MONUMENT 18" BELOW. THE MONUMENT AGREES WITH THE EXISTING TIE AND WITNESS TREE. ACCEPTED THE HARRISON MONUMENT AS THE CORNER LOCATION. SET 3 NEW TIES AND MEASURED TO THE TIES AND WITNESS TREE.

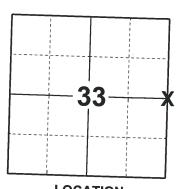

LOCATION (INDICATE CORNER BY "X")

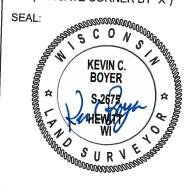

DATA SHOWN HERE ON THIS TIE SHEET IS CORRECT AND COMPLETE TO THE BEST OF MY KNOWLEDGE AND BELIEF.

PROFESSIONAL LAND SURVEYOR


DATE

-TIE SKETCH

NOTE: THE CORNER FALLS 0.5'± WEST OF THE CENTERLINE OF 10TH AVE.



- SET 3/4" x 18" IRON REBAR, 1.50#/FT
- FOUND 3/4" IRON ROD
- FOUND HARRISON MONUMENT
- STEEL FENCE POST
- VINYL "T" POST
- WITNESS TREE

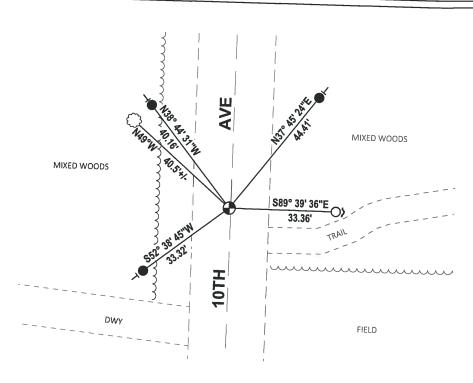

ADAMS COUNTY

Survey Monument Record

TYPE OF MONUMENT: 30" HARRISON STATE PLANE COORDINATES: N_

ELEVATION — M.S.L. DATUM:

THETA ANGLE: _

108 _ PAGE __**77** FIELD BOOK: ____


BASIS FOR MONUMENT LOCATION

(Use reverse side if necessary)

Show info such as: History of corner, with reference to Vol. and pg, dates, surveyor; exact description of monument replaced; if location computed, by taped or EDM traverse; landowner remarks, etc.

Set on a straight line equidistant between section corners.

OK 11-22-78 RN-55 1-TIEGONE, MON OK 8-19-92 5G-185 1-GONE, 1-NEW 2-13-98 Z-GONE, Z-NEW 1-6-03 - JG DK, 12-17-67- SG-55

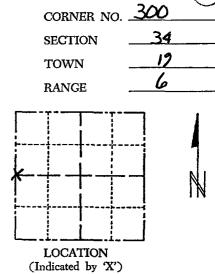

SEAL:



CERTIFIED CORRECT

