OG RANGE ADAMS COUNTY CORNER NO: 118 ROMPORTOL ID: 41906342000


PUBLIC LAND SURVEY MONUMENT RECORD

HARRISON (BROKEN-TOP) TYPE OF MONUMENT: ADAMS COUNTY COORDINATES, NAD 83 (2007) N. 258582.216 E. 546635.902 DATUM 12/17/2018 FIELD WORK DATE:

BASIS FOR MONUMENT LOCATION

1973 - PLS 878 CALCULATED THE CORNER LOCATION ON A STRAIGHT LINE EQUIDISTANT BETWEEN SECTION CORNERS. SET A HARRISON MONUMENT AT THE CALCULATED LOCATION AND TIED OUT.

2018 - PLS 2675 FOUND A HARRISON MONUMENT WITH A BROKEN-TOP 2" BELOW THE GROUND SURFACE AND 1 WITNESS TREE. THE MONUMENT AGREES WITH THE EXISTING WITNESS TREE. ACCEPTED THE HARRISON MONUMENT WITH A BROKEN-TOP AS THE CORNER LOCATION. SET 4 NEW TIES AND MEASURED TO THE TIES AND WITNESS TREE.

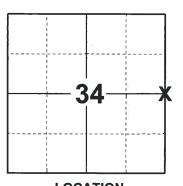

LOCATION (INDICATE CORNER BY "X")

SEAL:

DATA SHOWN HERE ON THIS TIE SHEET IS CORRECT AND COMPLETE TO THE BEST OF MY KNOWLEDGE AND BELIEF.


PROFESSIONAL LAND SURVEYOR

-18-19

-TIE SKETCH



- SET 3/4" x 18" IRON REBAR, 1.50#/FT
- FOUND HARRISON MONUMENT (BROKEN-TOP)
- STEEL FENCE POST
- VINYL "T" POST
- WITNESS TREE

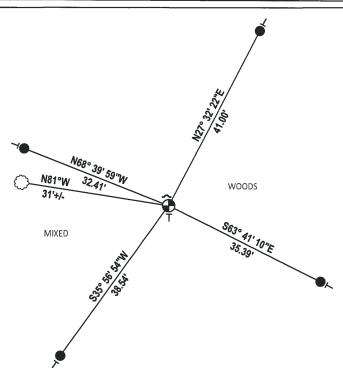

ADAMS COUNTY

Survey Monument Record

TYPE OF MONUMENT: 30" HARRISON STATE PLANE COORDINATES: N_

ELEVATION — M.S.L. DATUM: THETA ANGLE: .

_ PAGE _ FIELD BOOK: ____

BASIS FOR MONUMENT LOCATION

(Use reverse side if necessary)

Show info such as: History of corner, with reference to Vol. and pg, dates, surveyor; exact description of monument replaced; if location computed, by taped or EDM traverse; landowner

Set on a straight line equidistant between section corners.

> OK 4-18-83 6 R-55 1-8-93 36-BS

ALL OK, 2-23-98-JC TOP BROKEN 2 NEW TIES 12-17-07 55

CERTIFIED CORRECT:

SEAL:

Registered Land Surveyor DATE: 9/18/73

S-878 Wisconsin Rapids

CORNER NO. _30/

SECTION

TOWN

RANGE

LOCATION

(Indicated by 'X')

TIE SKETCH (Show at least four ties)

Ties are to nail and disc.

ויין אינויין

P. 6 /2"0AX

REVISED 1972

6" BLACK OAK

BLAZED ROAD SIDE