

32 SECTION 19 TOWN 06 RANGE

ADAMS COUNTY

COUNTY CORNER NO: 125

ROMPORTOL ID: 41906320000

PUBLIC LAND SURVEY MONUMENT RECORD

TYPE OF MONUMENT: ALUMINUM CAP IN CONCRETE
 ADAMS COUNTY COORDINATES, NAD 83 (2007)

N. 255949.361

E. 536152.434


ELEVATION- DATUM

FIELD WORK DATE: 01/22/2018

BASIS FOR MONUMENT LOCATION


1972 - PLS 981 CONCRETE MONUMENT CAPPED AT THE CORNER LOCATION, TIED OUT CORNER.

2018 - PLS 2994 FOUND AN ALUMINUM CAP IN CONCRETE 6" ABOVE THE GROUND SURFACE AND 1 WITNESS TREE. THE MONUMENT AGREES WITH THE EXISTING WITNESS TREE. ACCEPTED THE ALUMINUM CAP IN CONCRETE AS THE CORNER LOCATION. SET 4 NEW TIES AND MEASURED TO THE TIES AND WITNESS TREE.

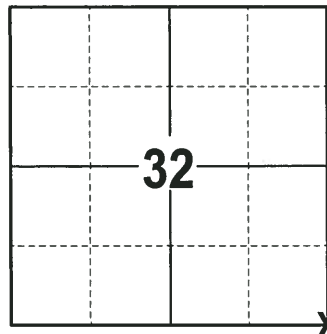

LOCATION
(INDICATE CORNER BY "X")

SEAL:

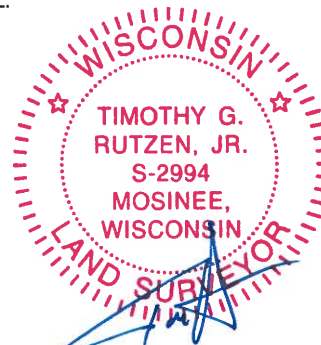

DATA SHOWN HERE ON THIS TIE SHEET IS CORRECT AND COMPLETE TO THE BEST OF MY KNOWLEDGE AND BELIEF.

PROFESSIONAL LAND SURVEYOR



DATE 3-1-18

- TIE SKETCH

NOTE 1: SET A 3/4" IRON ROD S 89°34'04" W, 17.37' OF THE CORNER LOCATION.

NOTE 2: FOUND A WITNESS TREE S 83° W, 17.7'± OF THE CORNER LOCATION.

NOTE 3: FOUND A 3/4" REBAR ON THE EAST EDGE OF THE ALUMINUM CAP IN CONCRETE.

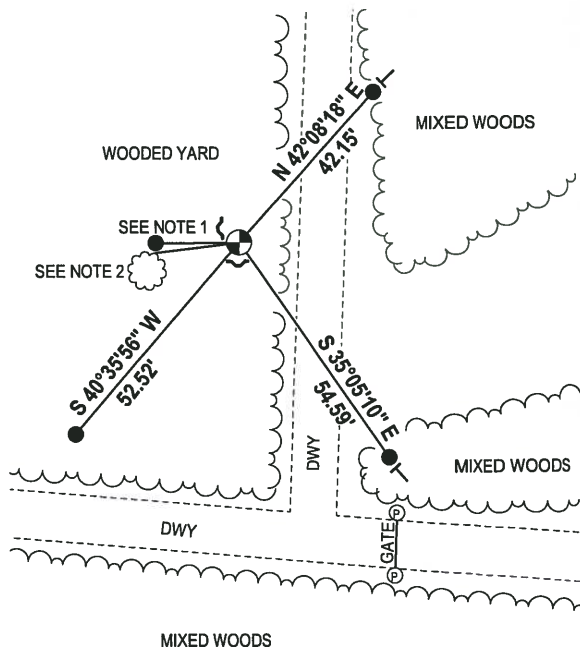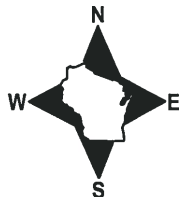

- 3/4" x 18" IRON REBAR SET, 1.50#/FT
- ⊕ ALUMINUM CAP IN CONCRETE FOUND
- ↗ STEEL FENCE POST
- └ VINYL "T" POST
- ☁ WITNESS TREE FOUND

ADAMS COUNTY

Survey Monument Record

TYPE OF MONUMENT: 30" HARRISON CONC. MON.

STATE PLANE COORDINATES: N _____
E _____

ELEVATION — M.S.L. DATUM: _____

THETA ANGLE: _____


FIELD BOOK: 103 PAGE 59

CORNER NO. 102

SECTION 33

TOWN 19

RANGE 6

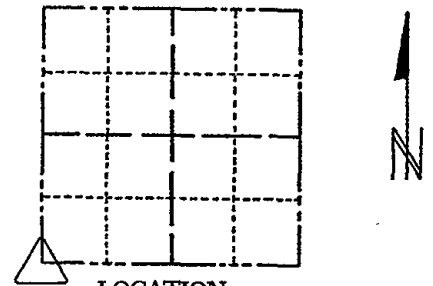

LOCATION
(Indicated by 'X')

SEAL:

BASIS FOR MONUMENT LOCATION

(Use reverse side if necessary)

Show info such as: History of corner, with reference to Vol. and pg, dates, surveyor; exact description of monument replaced; if location computed, by taped or EDM traverse; landowner remarks, etc.

Concrete monument capped

April 28, 1972

Sam T. Mullen R.L.S. S-981

- OK 11-29-78 RN-DA
- 3-9-83 GR-SS O.K.
- OK, 8-19-92 -JG
- OK, 2-11-98 -JG
- OK 12-12-02-JG
- Nov '08 - 2 NEW TIES STS

CERTIFIED CORRECT:

Registered Land Surveyor

DATE: _____

TIE SKETCH

(Show at least four ties)

