

11  
SECTION

19  
TOWN

07  
RANGE

# ADAMS COUNTY

COUNTY CORNER NO: 50

ROMPORTOL ID: 41907110020

## PUBLIC LAND SURVEY MONUMENT RECORD

TYPE OF MONUMENT: 3/4" x 24" IRON REBAR, 1.50#/FT  
ADAMS COUNTY COORDINATES, NAD 83 (1907)

N. 277193.145

E. 580622.962


ELEVATION- - - - DATUM - - - -

FIELD WORK DATE: 05/14/2019

### BASIS FOR MONUMENT LOCATION

1983 - PLS 1444 THIS CORNER WAS SET EQUIDISTANT AND ON LINE BETWEEN ADJACENT SECTION CORNERS. THIS CORNER FALLS IN A LARGE CULTIVATED FIELD AND NO TIES ARE AVAILABLE. MONUMENT IS 18" BELOW SURFACE.


2019 - PLS 2675 FOUND NO EVIDENCE OF THE CORNER OF ANY TIES OR WITNESSES TO THE CORNER. SET 3/4" IRON ROD ON A STRAIGHT LINE EQUIDISTANT BETWEEN THE SW AND SE CORNERS OF SECTION 9. THIS DISTANCE FITS WELL WITH THE ORIGINAL TIE SHEET DISTANCES FROM 1983 BY PLS 1444. ACCEPTED THE LOCATION AS THE CORNER LOCATION. SET A 3/4"X24" REBAR FOR THE CORNER 24" BELOW THE GROUND AND SET 4 NEW TIES.

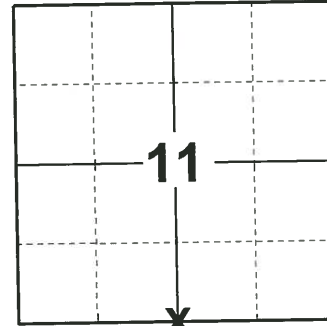

LOCATION

(INDICATE CORNER BY "X")

SEAL:


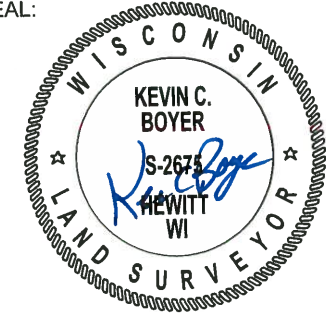


DATA SHOWN HERE ON THIS TIE SHEET IS CORRECT AND COMPLETE TO THE BEST OF MY KNOWLEDGE AND BELIEF.

PROFESSIONAL LAND SURVEYOR

DATE 6/4/19

### - TIE SKETCH

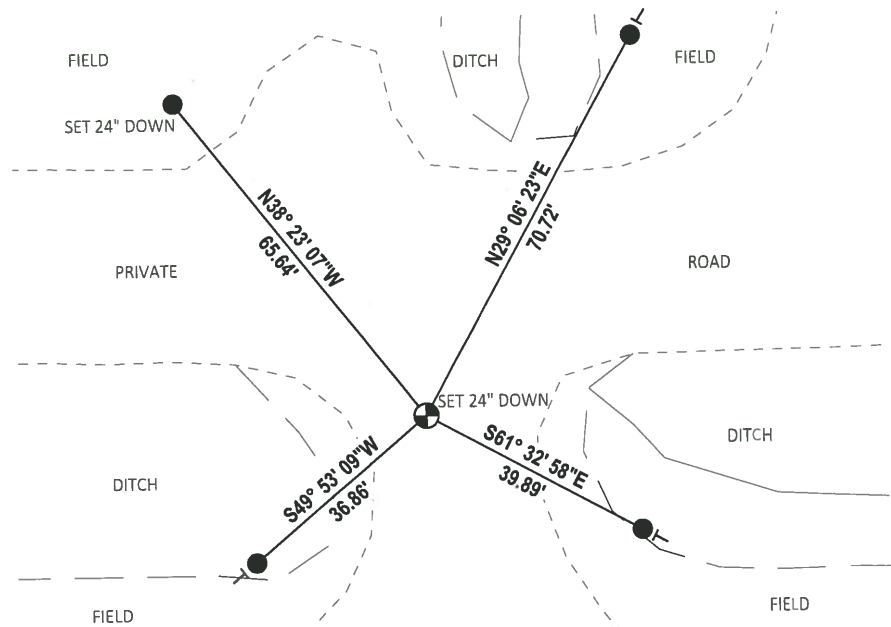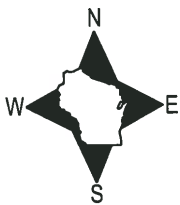

- SET 3/4" x 18" IRON REBAR, 1.50#/FT
- ⊕ SET 3/4" x 24" IRON REBAR, 1.50#/FT
- ⊣ VINYL "T" POST

# Government Land Corner Certificate

ADAMS County

TYPE OF MONUMENT: Harrison

STATE PLANE COORDINATES: N \_\_\_\_\_  
E \_\_\_\_\_


ELEVATION — M.S.L. DATUM: \_\_\_\_\_

THETA ANGLE: \_\_\_\_\_

FIELD BOOK: FILE PAGE \_\_\_\_\_

DRAWN BY: SJH

CORNER NO. 50  
SECTION 11  
TOWN 19  
RANGE 7

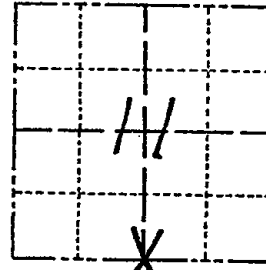


LOCATION  
(Indicated by 'X')

## BASIS FOR MONUMENT LOCATION

Show info such as: History of corner, with reference to Vol. and pg., dates, surveyor; exact description of monument replaced; if location computed, by taped or EDM traverse; landowner remarks, etc. (Use reverse side if necessary)

This corner was set equidistant and on line between adjacent Section corners. This corner falls in a large cultivated field and no ties are available. Monument is 18' below surface.

SEAL:

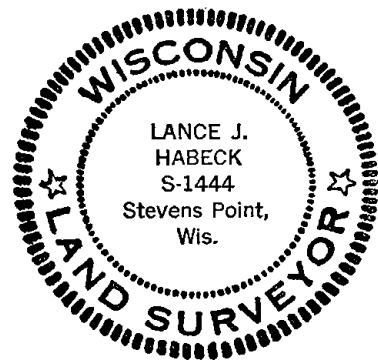

DATA SHOWN HERE ON  
CERTIFIED CORRECT:

Lance J. Habek  
Registered Land Surveyor

DATE: 4/29/83

## TIE SKETCH

Show at least four ties, also fence lines, roads, topo, size and type of witness trees' and if off road - best way to arrive at corner.

