19

ADAMS COUNTY COUNTY CORNER NO: 89

ROMPORTOL ID: 41907220000

PUBLIC LAND SURVEY MONUMENT RECORD

TYPE OF MONUMENT:	2-3/8" O.D. IRON PIPE
ADAMS COLINTY COORDINATES, NAD 83 (2007)	

N. 266605.674

E. 577989.139

ELEVATION- - — — DATUM

04/17/2019 FIELD WORK DATE:


BASIS FOR MONUMENT LOCATION

1983 - PLS 1551 SEARCH AREA FOR SIGNS OF CORNER, NOTHING FOUND. NO OLD OCCUPATION SIGNS IN AREA. CORNER WAS RESET BY DOUBLE PROPORTIONATE MEASUREMENT USING THE SW CORNER OF 22 AND THE SE CORNER OF 23 FOR E-W CONTROL AND THE NW CORNER OF 23 AND THE POSITION SURVEYOR PAUL CARROLL USED FOR THE NW CORNER OF 34 FOR N-S CONTROL. THIS LOCATION FITS ORIGINAL N-S MEASUREMENTS WITHIN 2.2' AND E-W MEASUREMENTS WITHIN 9.1'.

2019 - PLS 2675 FOUND 2-3/8" O.D. IRON PIPE 10" ABOVE THE SWAMP SURFACE AND 2 WITNESSES. THE MONUMENT AGREES WITH BOTH WITNESSES. ACCEPTED THE 2-3/8" O.D. IRON PIPE AS THE CORNER LOCATION. SET 4 NEW TIES AND MEASURED TO THE EXISTING WITNESSES.



(INDICATE CORNER BY "X")

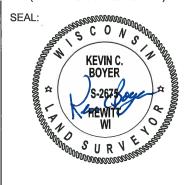


DATA SHOWN HERE ON THIS TIE SHEET IS CORRECT AND COMPLETE TO THE BEST OF MY KNOWLEDGE AND BELIEF.

PROFESSIONAL LAND SURVEYOR

-TIE SKETCH



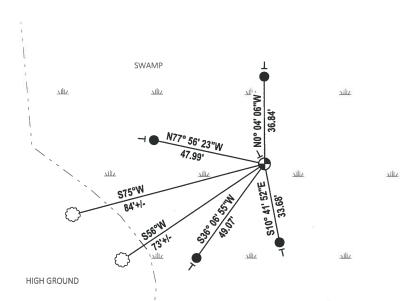

- SET 3/4" x 48" IRON REBAR, 1.50#/FT
- FOUND 2-3/8" O.D. IRON PIPE MONUMENT
- VINYL "T" POST
- WITNESS TREE

U.S. PUBLIC LAND SURVEY MONUMENT RECOR	<u> 20</u>
ADAMS COUNTY	CORNER NO. 89
ADAMS COUNTY TYPE OF MONUMENT: 2" I.D. x 60" galvanized pipe	SECTION 23
STATE PLANE COORDINATES: N	TOWN 19N
E	RANGE <u>7E</u>
ELEVATION — M.S.L. DATUM:	
THETA ANGLE:	
FIELD BOOK: Adams County PAGE 60	4
DRAWN BY: D. Riesop	- 2 3 - N I
DACIC FOR MONITATINE LOCATION	
BASIS FOR MONUMENT LOCATION	
Show info such as: History of corner, with reference to Vol. and pg., dates, surveyor; exact description of monument	*
replaced; if location computed, by taped or EDM traverse; landowner remarks, etc. (Use reverse side if necessary) (in conformance with Section A-E 502 of the	LOCATION (Indicated by 'X')
(in conformance with Section A-E 502 of the Wisconsin Administrative Code)	SEAL:
Searched area for signs of corner, nothing found. No	MAN CON COM
old occupation signs in area.	MISCONS IN
	DAVID C.
Corner was reset by double proportionate measurement using the SW corner of 22 and the SE corner of 23 for	DIECUD \$
E-W control and the NW corner of 23 and the position	CAMBRIDGE,
surveyor Paul Carroll used for the NW corner of 34	WISCONSIN OS
for N-S control.	The state of the s
This location fits original N-S measurements within	W.SURIME
2.2 and E-W measurements within 9.1.	DATA SHOWN HERE ON
	CERTIFIED CORRECT:
	1) 1/ (())
	Jana C. Jinean
	Registered Land Surveyor
	Registered Land Surveyor DATE: 7/28/83
TIT CUTTCII	
TIE SKETCH	DATE: 7/28/83
Show at least four ties, also fence lines, roads, topo, size and type of witness trees' and if off road - best way to	DATE: 7/28/83
Show at least four ties, also fence lines, roads, topo, size	DATE: 7/28/83
Show at least four ties, also fence lines, roads, topo, size and type of witness trees' and if off road - best way to arrive at corner.	DATE: 7/28/83
Show at least four ties, also fence lines, roads, topo, size and type of witness trees' and if off road - best way to arrive at corner.	DATE: 7/28/83 LAR SUPE S'POPLAR NOIL STILL SUPER NAIL STILL SUPER NAIL
Show at least four ties, also fence lines, roads, topo, size and type of witness trees' and if off road - best way to arrive at corner. filed for record this The state of the state o	DATE: 7/28/83 LAR. SPORGAR OZ MR OZ MR SIGN SIDE SIN SIDE IN SIDE
Show at least four ties, also fence lines, roads, topo, size and type of witness trees' and if off road - best way to arrive at corner.	DATE: 7/28/83 LAR SIDE S'POPLAR NAIL STANDER SON E STROPLAR NAIL STANDER SON E STROPLAR NAIL STANDER STROPLAR NAIL STANDER STROPLAR NAIL STANDER STROPLAR NAIL
Show at least four ties, also fence lines, roads, topo, size and type of witness trees and if off road - best way to arrive at corner. filed for record this server and if off road - best way to arrive at corner. ADAMS COUNTY SHAWOR	DATE: 7/28/83 LAR SUPE S'POPLAR NOIL STILL SUPER NAIL STILL SUPER NAIL
Show at least four ties, also fence lines, roads, topo, size and type of witness trees and if off road - best way to arrive at corner. filed for record this sections are sections and the section of th	DATE: 7/28/83 LAR SIDE S'POPLAR NAIL STANDER SON E STROPLAR NAIL STANDER SON E STROPLAR NAIL STANDER STROPLAR NAIL STANDER STROPLAR NAIL STANDER STROPLAR NAIL
Show at least four ties, also fence lines, roads, topo, size and type of witness trees' and if off road - best way to arrive at corner. filed for record this servers 19. 2.2.2.2.2.2.2.2.2.2.2.2.2.2.2.2.2.2.2	DATE: 7/28/83 LAR SIDE S'POPLAR NAIL STANDER SON E STROPLAR NAIL STANDER SON E STROPLAR NAIL STANDER STROPLAR NAIL STANDER STROPLAR NAIL STANDER STROPLAR NAIL
Show at least four ties, also fence lines, roads, topo, size and type of witness trees and if off road - best way to arrive at corner. filed for record this	DATE: 7/28/83 LAR SIDE S'POPLAR NAIL STANDE S'POPLAR NAIL STAND
Show at least four ties, also fence lines, roads, topo, size and type of witness trees and if off road - best way to arrive at corner. filed for record this server and the server and th	DATE: 7/28/83 LAR SUPE S'POPLAR NOIL STANDE S'POPLAR NAIL STAND
Show at least four ties, also fence lines, roads, topo, size and type of witness trees and if off road - best way to arrive at corner. filed for record this 19 - 2 - 2 - 2 - 2 - 2 - 2 - 2 - 2 - 2 -	DATE: 7/28/83 LAR RESIDE S'POPCAR OZ MR S'POPLAR MAIL ON SIDE H"POPLAR NAIL IN E. SIDE
Show at least four ties, also fence lines, roads, topo, size and type of witness trees and if off road - best way to arrive at corner. filed for record this server and if off road - best way to day of the server and	DATE: 7/28/83 LAR RESIDE S'POPLAR OZ MR OZ MR S'POPLAR MAIL OS M H"POPLAR NAIL IN E. SIDE ADD SICK
Show at least four ties, also fence lines, roads, topo, size and type of witness trees' and if off road - best way to arrive at corner. filed for record this	DATE: 7/28/83 LAR ASIDE S'POPLAR SONE Z''BOPLAR NAIL OF THE SIDE ADD SIGN FACING N.
Show at least four ties, also fence lines, roads, topo, size and type of witness trees' and if off road - best way to arrive at corner. filed for record this	DATE: 7/28/83 LAR RESIDE S'POPCAR OZ NR S'POPCAR MAIL ON SIDE H"POPLAR NAIL IN E. SIDE ADD SICK

__