

23 SECTION 19 TOWN 07 RANGE

ADAMS COUNTY

COUNTY CORNER NO: 91
 ROMPORTOL ID: 41907230000

PUBLIC LAND SURVEY MONUMENT RECORD

TYPE OF MONUMENT: HARRISON (BROKEN-TOP)
 ADAMS COUNTY COORDINATES, NAD 83 (2007)

N. 266643.892

E. 583346.597


ELEVATION- _____ DATUM _____

FIELD WORK DATE: 05/20/2019

BASIS FOR MONUMENT LOCATION

1973 - PLS 878 LOCATION DETERMINED FROM DATA GATHERED FROM A CLOSED TRAVERSE OF ALL OF SECTIONS 24 AND 25, COMPARING POSSESSION LINES AND ORIGINAL NOTES. EXCAVATED AREA WITH A BACKHOE, BUT DID NOT FIND ANY EVIDENCE OF ANY MARK. SET MONUMENT JULY 25, 1972

2019 - PLS 2675 FOUND MAG-NAIL IN THE ROAD SURFACE, REMOVED AND FOUND A HARRISON (BROKEN-TOP) 24" BELOW THE ROAD SURFACE. ACCEPTED THE HARRISON (BROKEN-TOP) AS THE CORNER LOCATION. SET 3 NEW TIES AND MEASURED TO A FOUND PROPERTY IRON.

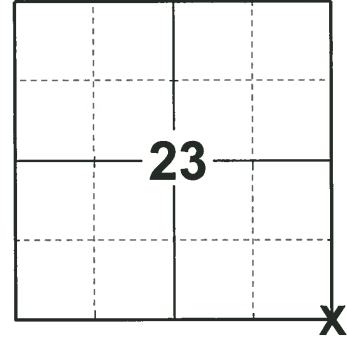

LOCATION

(INDICATE CORNER BY "X")

SEAL:




DATA SHOWN HERE ON THIS TIE SHEET IS CORRECT AND COMPLETE TO THE BEST OF MY KNOWLEDGE AND BELIEF.

PROFESSIONAL LAND SURVEYOR

DATE 6/4/19

TIE SKETCH

NOTE: THE CORNER LANDS 2± EAST OF CENTERLINE OF CTH "G"

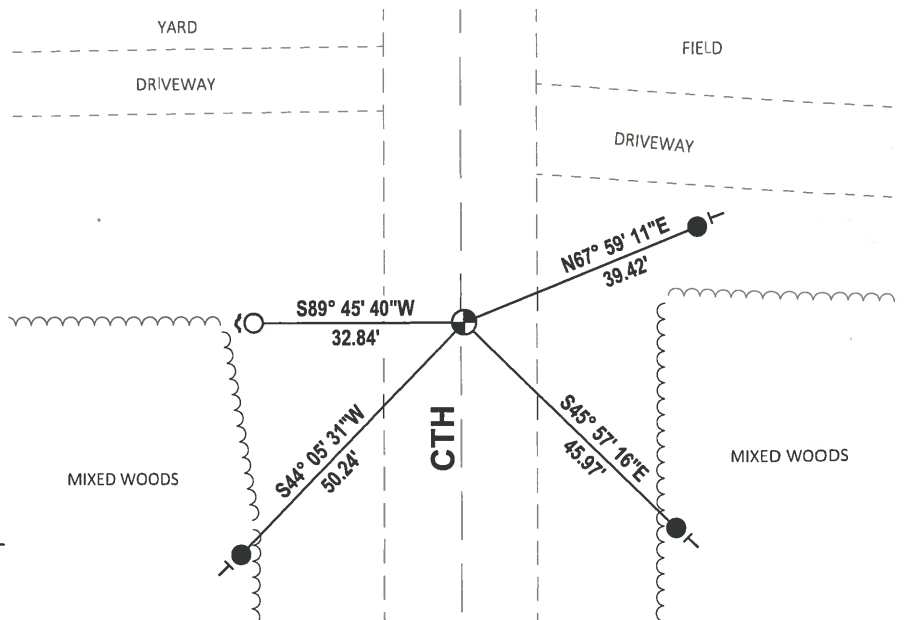

- SET 3/4" x 18" IRON REBAR, 1.50#/FT
- FOUND 3/4" IRON ROD
- ⊕ FOUND HARRISON (BROKEN-TOP) MONUMENT
- ~ STEEL FENCE POST
- ┌ VINYL "T" POST

ADAMS COUNTY

Survey Monument Record

TYPE OF MONUMENT: 30" HARRISON

STATE PLANE COORDINATES: N _____

E _____

ELEVATION — M.S.L. DATUM: _____

THETA ANGLE: _____


FIELD BOOK: 106? PAGE ?

CORNER NO. 164 91

SECTION 25

TOWN 19

RANGE 7

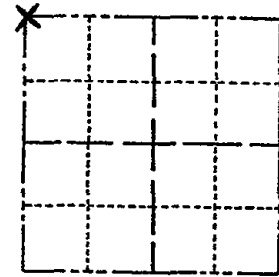

LOCATION
(Indicated by 'X')

SEAL:



BASIS FOR MONUMENT LOCATION

(Use reverse side if necessary)

Show info such as: History of corner, with reference to Vol. and pg, dates, surveyor; exact description of monument replaced; if location computed, by taped or EDM traverse; landowner remarks, etc.

Set monument

July 25, 1972

Anthony B. Kiedrowski R.L.S. 878

Location determined from data gathered from a closed traverse of all of sections 24 and 25, comparing possession lines and original notes. Excavated area with a backhoe but did not find any evidence of any mark.

O.K. 4-4-77 RR-SS
 TOP IS GONE 3-18-82 GR-SS
 2-18-82 3-18-82 SS
 1-8-92 OK - KZ-JG
 COR OK 3/28/97 JG-SS

CERTIFIED CORRECT:

Anthony B. Kiedrowski
 Registered Land Surveyor

DATE: 1-1-73

TIE SKETCH OK 1-30-02 JG

OK, 9-24-07-JG

(Show at least four ties)

