

28 SECTION 19 TOWN 07 RANGE

# ADAMS COUNTY

COUNTY CORNER NO: 97  
ROMPORTOL ID: 41907282000

## PUBLIC LAND SURVEY MONUMENT RECORD

TYPE OF MONUMENT: 2-3/8" O.D. IRON PIPE  
ADAMS COUNTY COORDINATES, NAD 83 (2007)

N. 263991.938

E. 572740.517


ELEVATION- \_\_\_\_\_ DATUM \_\_\_\_\_

FIELD WORK DATE: 05/06/2019

### BASIS FOR MONUMENT LOCATION

1983 - PLS 1551 NO EVIDENCE OF ORIGINAL CORNER STAKE, BEARING TREES, OR OCCUPATION WAS FOUND. CORNER WAS RESET PROPORTIONALLY ON A STRAIGHT LINE BETWEEN ADJACENT SECTION CORNERS.

2019 - PLS 2675 FOUND 2-3/8" O.D. IRON PIPE 30" ABOVE THE SWAMP WATERLINE AND 1 WITNESS. THE MONUMENT AGREES WITH THE EXISTING WITNESS. ACCEPTED THE 2-3/8" O.D. IRON PIPE AS THE CORNER LOCATION. SET 4 NEW TIES AND MEASURED TO THE EXISTING WITNESS.

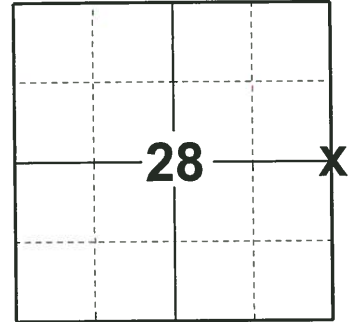

### LOCATION

(INDICATE CORNER BY "X")

SEAL:





DATA SHOWN HERE ON THIS TIE SHEET IS CORRECT AND COMPLETE TO THE BEST OF MY KNOWLEDGE AND BELIEF.

PROFESSIONAL LAND SURVEYOR

DATE 6/4/19

### TIE SKETCH

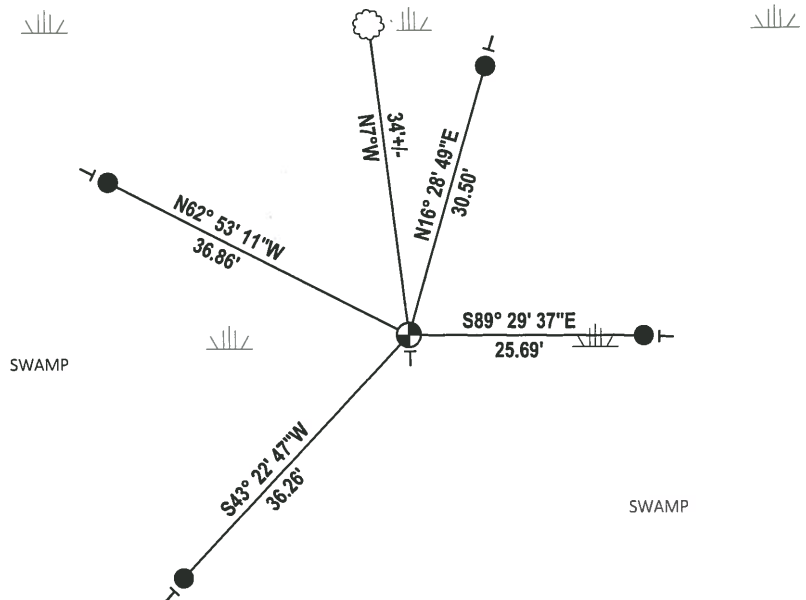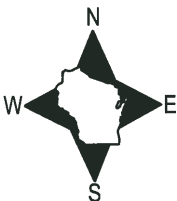

- SET 3/4" x 48" IRON REBAR, 1.50#/FT
- FOUND 2-3/8" O.D. IRON PIPE MONUMENT
- ┆ VINYL "T" POST
- ☁ WITNESS TREE

# U.S. PUBLIC LAND SURVEY MONUMENT RECORD

## ADAMS COUNTY

TYPE OF MONUMENT: 2" I.D. x 66" galvanized pipe

STATE PLANE COORDINATES: N \_\_\_\_\_  
E \_\_\_\_\_

ELEVATION — M.S.L. DATUM: \_\_\_\_\_

THETA ANGLE: \_\_\_\_\_

FIELD BOOK: 1 PAGE 11


DRAWN BY: D. Riesop

CORNER NO. 97

SECTION 27

TOWN 19N

RANGE 7E

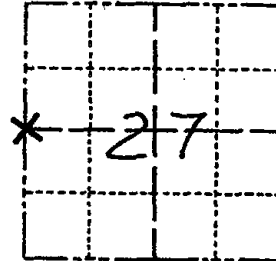

LOCATION  
(Indicated by 'X')


### BASIS FOR MONUMENT LOCATION

Show info such as: History of corner, with reference to Vol. and pg., dates, surveyor; exact description of monument replaced; if location computed, by taped or EDM traverse; landowner remarks, etc. (Use reverse side if necessary)  
(in conformance with Section A-E 502 of the Wisconsin Administrative Code)

No evidence of original corner stake, bearing trees, or occupation was found.

Corner was reset proportionally on a straight line between adjacent section corners.

SEAL:

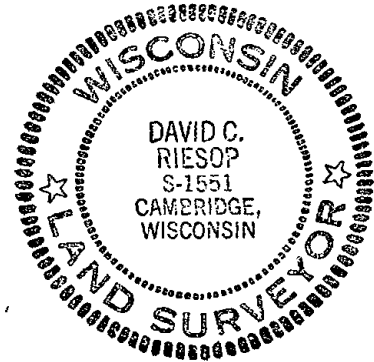


DATA SHOWN HERE ON  
CERTIFIED CORRECT:

David C. Riesop  
Registered Land Surveyor

DATE: 11/28/83

### TIE SKETCH

Show at least four ties, also fence lines, roads, topo, size and type of witness trees and if off road - best way to arrive at corner.

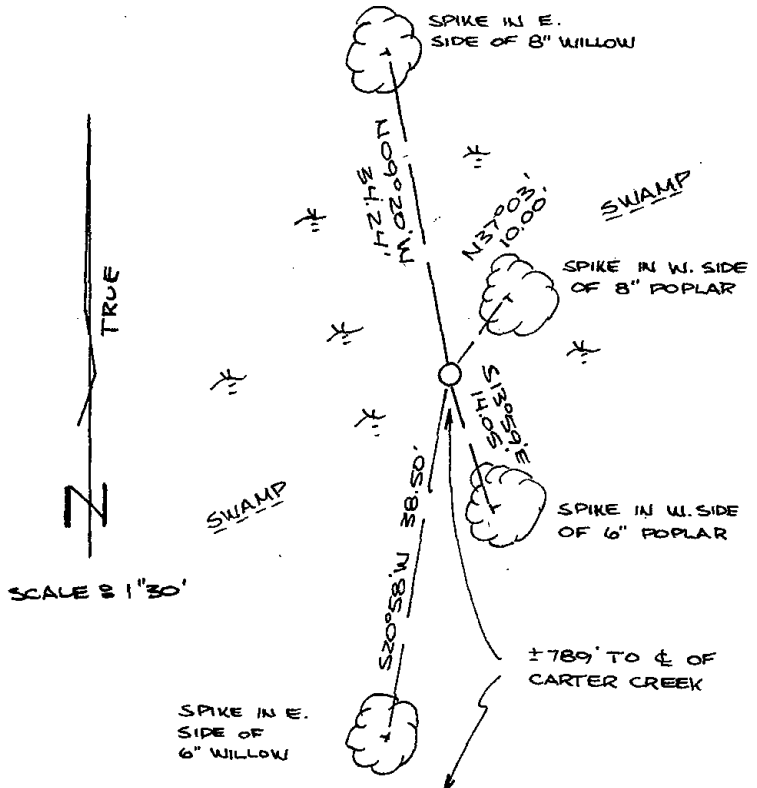

### MAINTENANCE RECORD

| Date    | Init. | Remarks |
|---------|-------|---------|
| 6-11-92 | JG-BS | ALL OK  |
|         |       |         |
|         |       |         |
