ADAMS COUNTY Survey Monument Record TYPE OF MONUMENT: 30" HARRISON STATE PLANE COORDINATES: N______ E ELEVATION — M.S.L. DATUM: _____ THETA ANGLE: _____ FIELD BOOK: ______ 107 ____ PAGE _______ 26

BASIS FOR MONUMENT LOCATION

(Use reverse side if necessary)


Show info such as: History of corner, with reference to Vol. and pg, dates, surveyor; exact description of monument replaced; if location computed, by taped or EDM traverse; landowner remarks, etc.

Set monument

October 19, 1972

Anthony B. Kiedrowski R.L.S. 878

Excavated sizable area with backhoe. Found nothing. This point located by traversing entire section, and also measuring a mile to the south, comparing all possession lines and original notes.

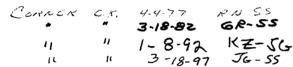

CORNER NO. 276

SECTION 36

TOWN 19

RANGE 7

LOCATION (Indicated by 'X')

SEAL:


ANTHONY B.
KIEDROWSKI
S-878
Wisconsin Rapids.
Wis.

CERTIFIED CORRECT:

Say Say No. King Source Co.

Registered Land Surveyor

DATE: 2 - 2 2 - 7 3

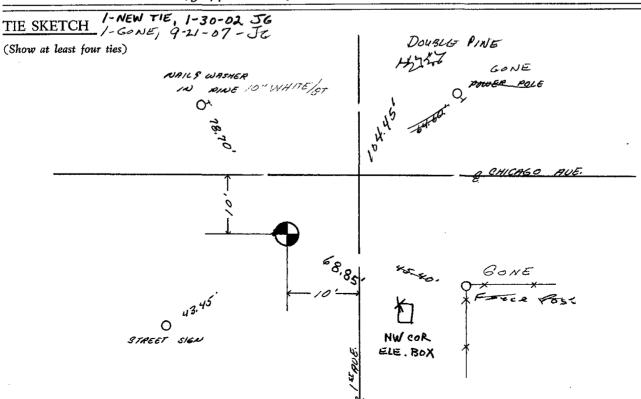

U.S. PUBLIC LAND SURVEY MONUMENT RECORD 133 CORNER NO. ADAMS COUNTY 36 SECTION Standard Harrison TYPE OF MONUMENT: _ 19N TOWN STATE PLANE COORDINATES: 7E RANGE ELEVATION — M.S.L. DATUM: _ THETA ANGLE: _ FIELD BOOK: _ DRAWN BY: D. Riesop BASIS FOR MONUMENT LOCATION Show info such as: History of corner, with reference to Vol. and pg., dates, surveyor; exact description of monument replaced; if location computed, by taped or EDM traverse; landowner remarks, etc. (Use reverse side if necessary) (in conformance with Section A-E 502 of the LOCATION (Indicated by 'X') SEAL: PHILIPPE CONSTANT Wisconsin Administrative Code) Monument was found in position other than that shown on Adams County tie sheet dated 2/22/73. Hole was DAVID C RIESOP found in pavement where monument had been removed. S-1551 CAMBRIDGE Ties were tken as shown. DATA SHOWN HERE ON CERTIFIED CORRECT: Registered Land Surveyor 11/28/83 DATE: DOUBLE 466 PINE, NAIL IN TIE SKETCH W. SIDE Show at least four ties, also fence lines, roads, topo, size and type of witness trees' and if off road - best way to arrive at corner. NAIL É WASHER IN W. PINE, PREVIOUSLY NAIL IN POWER POLE , PREVIOUSLY USED AS TIE HOLE IN PUMT MAINTENANCE RECORD Remarks Date Init. z OK 2-9.47 METAL POST FOR 516N