

PUBLIC LAND SURVEY MONUMENT RECORD

TYPE OF MONUMENT: HARRISON
 ADAMS COUNTY COORDINATES, NAD 83 (2007)

N. 316623.482

E. 514945.565


ELEVATION- DATUM

FIELD WORK DATE: 06/04/2018

BASIS FOR MONUMENT LOCATION

1982- PLS 1167 SEARCHED AREA FOR EVIDENCE OF CORNER. SEARCH EFFORT FAILED TO EXPOSE SAID DATA NEEDED. CALCULATED THE CORNER BY DOUBLING THE DISTANCE ON A STRAIGHT LINE FROM WEST 1/4 AND NW CORNER AND SET A HARRISON AND TIED OUT.


2018- PLS 2994 FOUND A HARRISON MONUMENT FLUSH WITH THE GROUND SURFACE. FOUND NO EVIDENCE OF ANY OF THE WITNESSES. ACCEPTED THE HARRISON MONUMENT AS THE BEST EVIDENCE OF THE CORNER LOCATION. SET 4 NEW TIES AND MEASURED TO THE TIES. (FOR BEST ACCESS USE DRIVEWAY #135, STOP AT THE HOUSE IF LANDOWNER IS HOME, HE CAN DRIVE YOU TO THE CORNER LOCATION.)

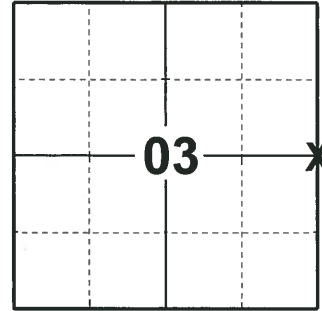

LOCATION

(INDICATE CORNER BY "X")

SEAL:

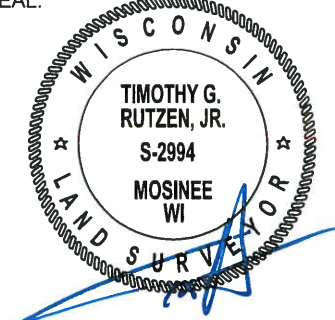


DATA SHOWN HERE ON THIS TIE SHEET IS CORRECT AND COMPLETE TO THE BEST OF MY KNOWLEDGE AND BELIEF.

PROFESSIONAL LAND SURVEYOR

DATE 7-18-18

TIE SKETCH

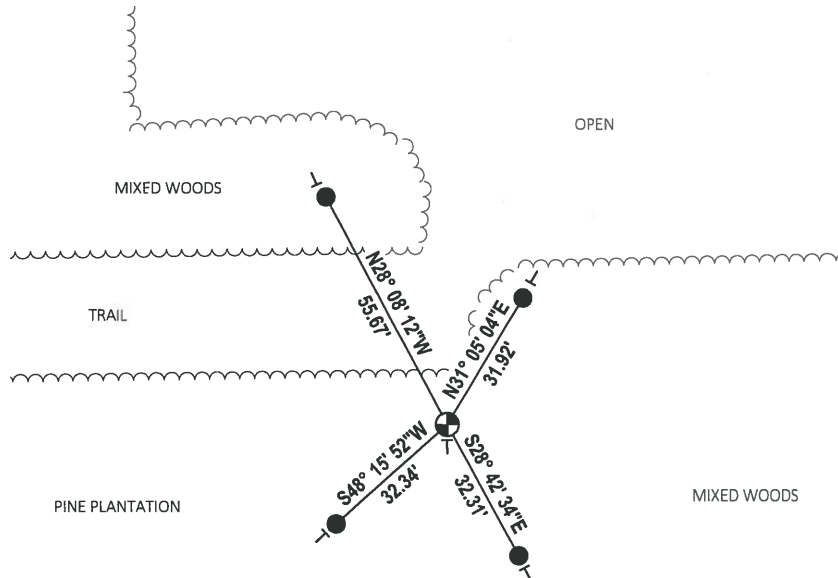


- SET 3/4" x 18" IRON REBAR, 1.50#/FT
- ⊕ FOUND HARRISON MONUMENT
- | VINYL "T" POST

Government Land Corner Certificate

ADAMS County
 TYPE OF MONUMENT: HARRISON
 STATE PLANE COORDINATES: N _____
 E _____
 ELEVATION — M.S.L. DATUM: _____
 THETA ANGLE: _____
 FIELD BOOK: _____ PAGE _____
 DRAWN BY: R. NUBER

CORNER NO. 18
 SECTION 2
 TOWN 20
 RANGE 5

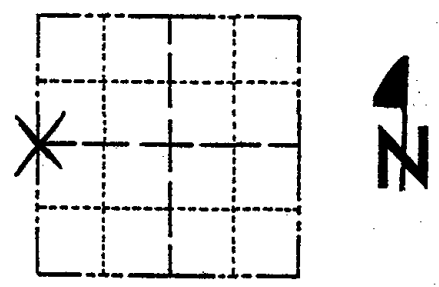


LOCATION
 (Indicated by 'X')

BASIS FOR MONUMENT LOCATION

Show info such as: History of corner, with reference to Vol. and pg., dates, surveyor; exact description of monument replaced; if location computed, by taped or EDM traverse; landowner remarks, etc. (Use reverse side if necessary)

Searched area for evidence of corner. Search effort failed to expose said needed data. Set corner by doubling the distance on a straight line from W $\frac{1}{4}$ Cor. & NW Cor. 11-20-5E

SEAL:

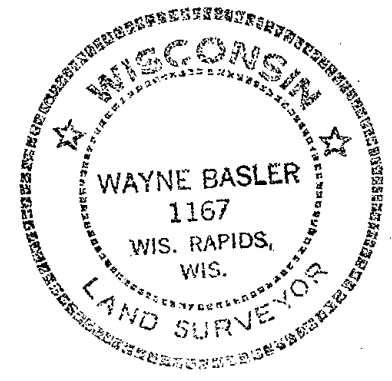


DATA SHOWN HERE ON
 CERTIFIED CORRECT:

Wayne Basler
 Registered Land Surveyor

DATE: 5-11-82

TIE SKETCH

Show at least four ties, also fence lines, roads, topo, size and type of witness trees and if off road - best way to arrive at corner.

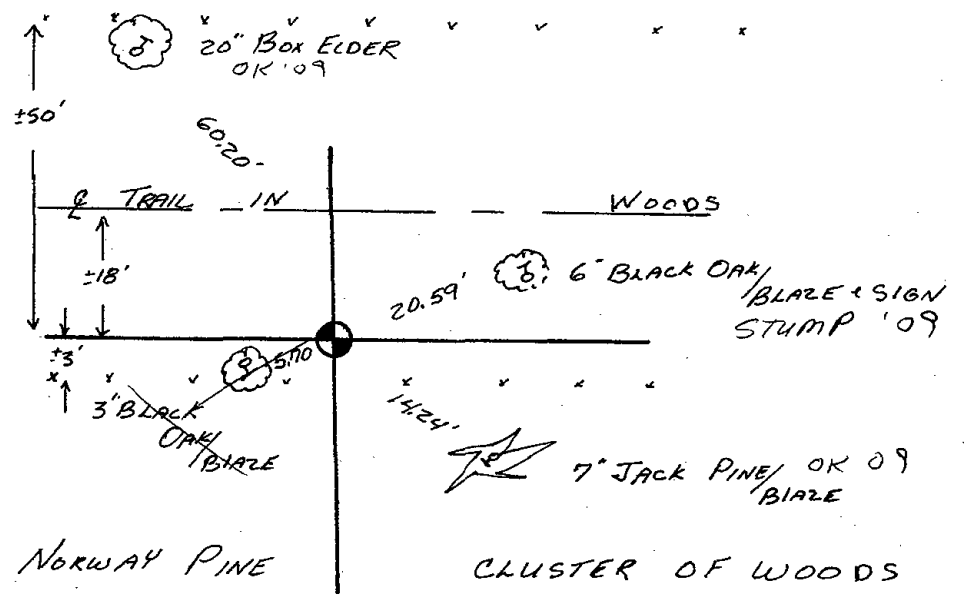

PLANTED NORWAY PINE

CLUSTER OF WOODS

