

PUBLIC LAND SURVEY MONUMENT RECORD


TYPE OF MONUMENT: **2-3/8" O.D. IRON PIPE W/ALUMINUM CAP (MEANDER CORNER)**
 ADAMS COUNTY COORDINATES, NAD 83 (2007)

N. 295227.803

E. 509673.909

ELEVATION- _____ DATUM _____


FIELD WORK DATE: 06/11/2018

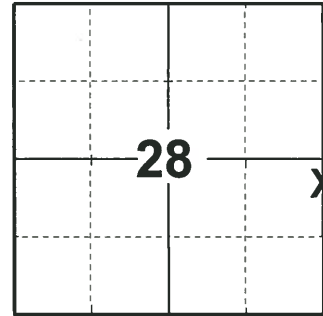

LOCATION

(INDICATE CORNER BY "X")

SEAL:

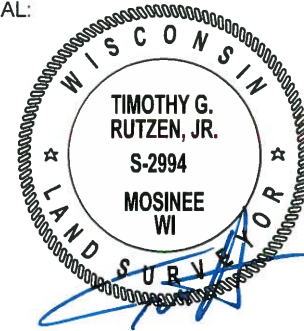



DATA SHOWN HERE ON THIS TIE SHEET IS CORRECT AND COMPLETE TO THE BEST OF MY KNOWLEDGE AND BELIEF.

PROFESSIONAL LAND SURVEYOR

DATE 7-18-18

TIE SKETCH

NOTE: THE CORNER FALLS 6± SOUTHEAST OF THE CENTERLINE OF THE TRAIL.

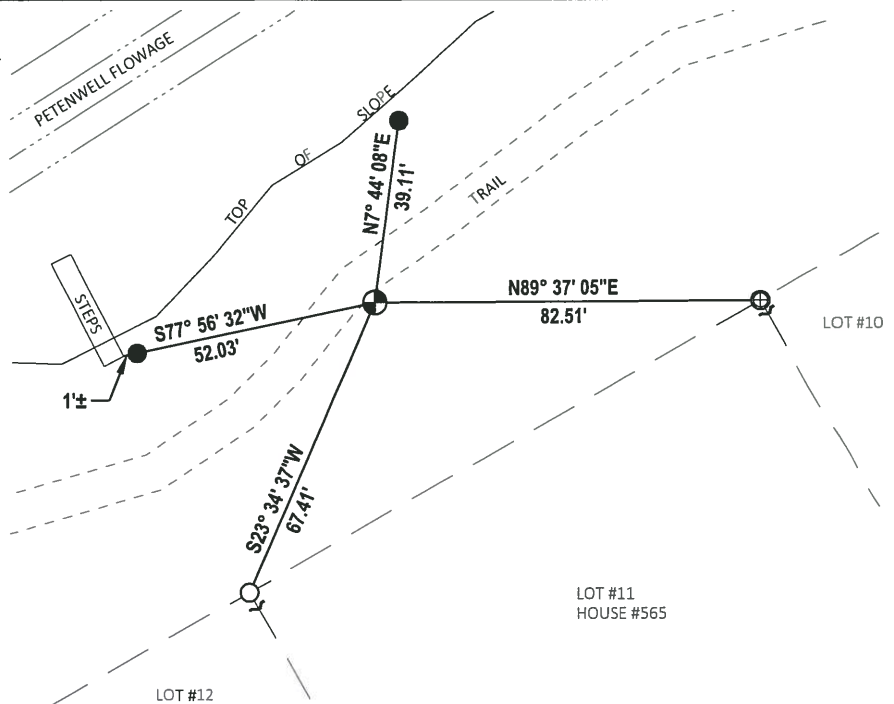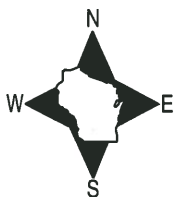

- SET 3/4" x 18" IRON REBAR, 1.50#/FT
- FOUND 3/4" IRON ROD
- ⊕ FOUND 1" IRON ROD
- ⊙ 2-3/8" O.D. IRON PIPE W/ALUMINUM CAP
- ┘ STEEL FENCE POST