


# Government Land Corner Certificate

ADAMS County  
 TYPE OF MONUMENT: HARRISON  
 STATE PLANE COORDINATES: N \_\_\_\_\_  
 E \_\_\_\_\_  
 ELEVATION — M.S.L. DATUM: \_\_\_\_\_  
 THETA ANGLE: \_\_\_\_\_  
 FIELD BOOK: 86 PAGE 85  
 DRAWN BY: N.J.

CORNER NO. 140  
 SECTION 1  
 TOWN 20  
 RANGE 6

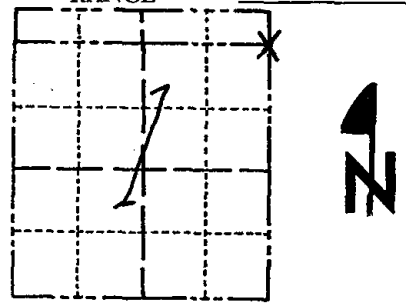

LOCATION (Indicated by 'X')

## BASIS FOR MONUMENT LOCATION

Show info such as: History of corner, with reference to Vol. and pg., dates, surveyor; exact description of monument replaced; if location computed, by taped or EDM traverse; landowner remarks, etc. (Use reverse side if necessary)

No record of any resurveys. No evidence of the original or subsequent monument found. This corner is set on a straight line between section corners and in proportion to the original notes.

Ok 7-9-84 GR-DK

*AREA HAS BEEN RESHAPED & SOME FILLED  
 BRASS CAP ONLY TIE LEFT - NEED TO RESURVEY  
 TO RESET? SS 6-30-04*

SEAL:



DATA SHOWN HERE ON CERTIFIED CORRECT:

*Anthony B. Kiedrowski*  
Registered Land Surveyor

DATE: 1/5/81

## TIE SKETCH

Show at least four ties, also fence lines, roads, topo, size and type of witness trees and if off road - best way to arrive at corner.

