

05 SECTION 20 TOWN 06 RANGE

# ADAMS COUNTY

COUNTY CORNER NO: 4  
 ROMPORTOL ID: 42006059020

## PUBLIC LAND SURVEY MONUMENT RECORD

TYPE OF MONUMENT: HARRISON  
 ADAMS COUNTY COORDINATES, NAD 83 (2007)

N. 321662.661

E. 533173.715


ELEVATION- --- DATUM ---

FIELD WORK DATE: 12/22/2016

### BASIS FOR MONUMENT LOCATION


1981 - PLS 878 SET A HARRISON HALF WAY BETWEEN THE NW AND NE CORNERS OF SECTION 5 AND ON A STRAIGHT LINE BETWEEN ADJACENT WOOD COUNTY CORNERS.

2017 - PLS 2994 FOUND EXISTING HARRISON WITH THE TOP BROKE OFF 15 INCHES BELOW THE ROAD SURFACE AND ONE WITNESS TREE. THE HARRISON AGREES WITH THE EXISTING WITNESS TREE. ACCEPTED HARRISON AND SET 2 NEW TIES AND TIED TO 2 EXISTING IRONS.

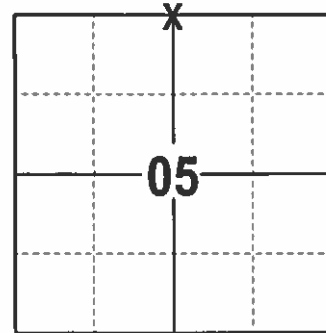

**LOCATION**  
 (INDICATE CORNER BY "X")

SEAL:

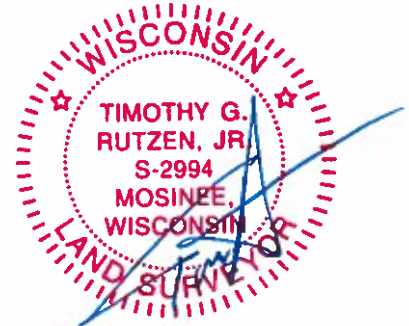


DATA SHOWN HERE ON THIS TIE SHEET IS CORRECT AND COMPLETE TO THE BEST OF MY KNOWLEDGE AND BELIEF.

PROFESSIONAL LAND SURVEYOR

DATE 2/9/17

### - TIE SKETCH

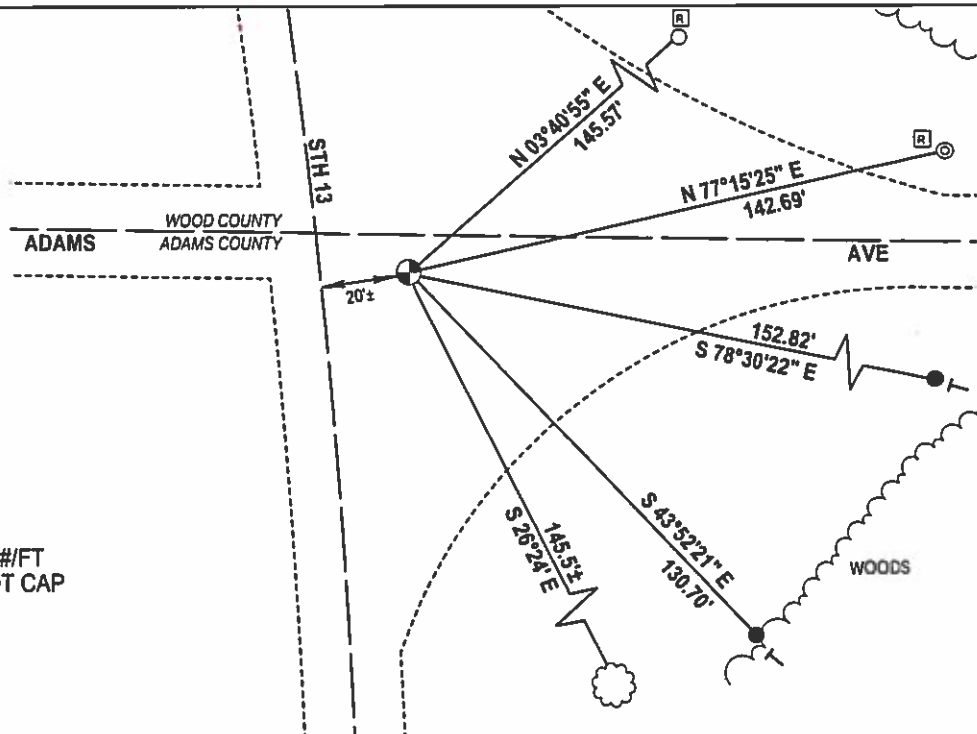


- 3/4" x 18" IRON REBAR SET, 1.50#/FT
- ⊙ 3/4" REBAR FOUND WITH WisDOT CAP
- 1-1/4" OD IRON PIPE FOUND
- ⊕ HARRISON FOUND
- ⊠ 4"x4" R/W GUARD POST
- ┆ VINYL "T" POST
- ☁ WITNESS TREE FOUND

# Government Land Corner Certificate

ADAMS County  
 TYPE OF MONUMENT: HARRISON  
 STATE PLANE COORDINATES: N \_\_\_\_\_  
 E \_\_\_\_\_  
 ELEVATION — M.S.L. DATUM: \_\_\_\_\_  
 THETA ANGLE: \_\_\_\_\_  
 FIELD BOOK: 69 PAGE 120  
 DRAWN BY: L.C.

CORNER NO. 4  
 SECTION 5  
 TOWN 20  
 RANGE 6

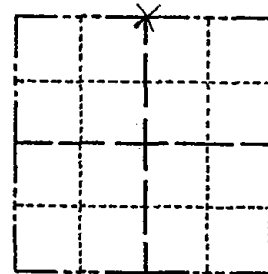

LOCATION  
(Indicated by 'X')

## BASIS FOR MONUMENT LOCATION

Show info such as: History of corner, with reference to Vol. and pg., dates, surveyor; exact description of monument replaced; if location computed, by taped or EDM traverse; landowner remarks, etc. (Use reverse side if necessary)

This corner is set half way between the NW and NE corners of section 5, and on a straight line between the adjacent Wood County corners.

Ok 5-7-84 SS-DK  
 TIES OK 1-23-89 SS  
 OK 4-11-89  
 OK 3-7-94 GR-JG  
 OK 2-12-99 - JG  
 OK 2-26-04-JG  
 " 3-13-09 SS

SEAL:



DATA SHOWN HERE ON  
CERTIFIED CORRECT:

*Anthony B. Kiedrowski*  
Registered Land Surveyor

DATE: 6/17/81

## TIE SKETCH

Show at least four ties, also fence lines, roads, topo, size and type of witness trees' and if off road - best way to arrive at corner.

