

04
SECTION

20
TOWN

06
RANGE

ADAMS COUNTY

COUNTY CORNER NO: 7

ROMPORTOL ID: 42006049000

PUBLIC LAND SURVEY MONUMENT RECORD

TYPE OF MONUMENT: 2-3/8" OD IRON PIPE
ADAMS COUNTY COORDINATES, NAD 83 (2007)

N. 321526.280

E. 541105.785


ELEVATION- - - DATUM - -

FIELD WORK DATE: 12/20/2016

BASIS FOR MONUMENT LOCATION


1974 - PLS 1103 TRAVERSED THE ENTIRE SECTION AND AFTER AN EXTENSIVE SEARCH FOUND A 2" IRON PIPE. ACCEPTED AS CORRECT AND LEFT THE 2" IRON PIPE IN PLACE.

2017 - PLS 2994 FOUND EXISTING 2-3/8" OD IRON PIPE, 4 EXISTING IRONS AND 1 WITNESS TREE. THE 2-3/8" OD IRON PIPE AGREES WITH THE EXISTING TIE IN THE SW AND THE WITNESS TREE. ACCEPTED THE 2-3/8" OD IRON PIPE AND MEASURED TO THE 4 EXISTING IRONS.

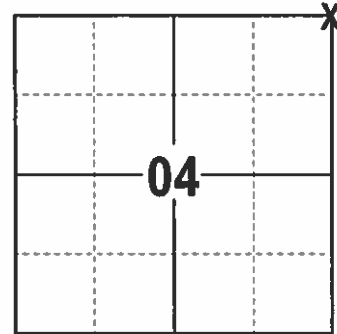

LOCATION
(INDICATE CORNER BY "X")

SEAL:


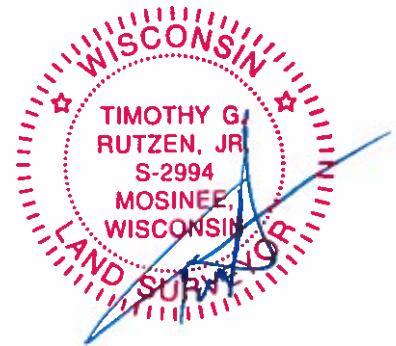


DATA SHOWN HERE ON THIS TIE SHEET IS CORRECT AND COMPLETE TO THE BEST OF MY KNOWLEDGE AND BELIEF.

PROFESSIONAL LAND SURVEYOR

DATE 2/9/17

- TIE SKETCH

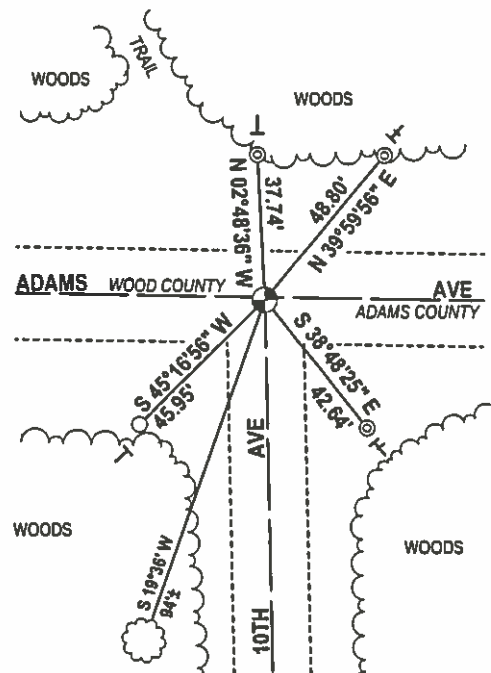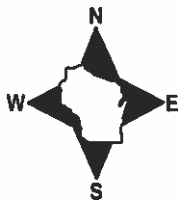

- 3/4" x 18" IRON REBAR SET, 1.50#/FT
- ⊙ 3/4" IRON REBAR FOUND
- 1" OD IRON PIPE FOUND
- ⊕ 2-3/8" OD IRON PIPE FOUND
- | VINYL "T" POST
- | EXISTING STEEL POST
- ⊙ WITNESS TREE FOUND

ADAMS COUNTY

CORNER NO. 517

7

Survey Monument Record

SECTION 4

TYPE OF MONUMENT: HARRISON STANDARD

TOWN * 20

STATE PLANE COORDINATES: N _____


RANGE 6

E _____

ELEVATION — M.S.L. DATUM: _____

THETA ANGLE: _____

FIELD BOOK: _____ PAGE _____

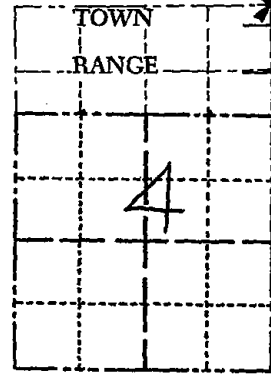

LOCATION (Indicated by 'X')

SEAL:



BASIS FOR MONUMENT LOCATION

(Use reverse side if necessary)

Show info such as: History of corner, with reference to Vol. and pg, dates, surveyor; exact description of monument replaced; if location computed, by taped or EDM traverse; landowner remarks, etc.

Traversed entire section and after extensive search located a two inch iron pipe, accepted as correct and monumented same.

Ok 5-11-84 DK-SS

FD 2" IP 9-16-09
CHECK CSM SW

OK RN? Aug 79?
OK 2-23-94 SS
OK 3-7-94 JG-GR
OK 2-12-99-JG
2-NEW, 2-27-04-JG
OK 3-19-09 SS

CERTIFIED CORRECT:

Dale C. Hagen
Registered Land Surveyor

DATE: 10-21-77

TIE SKETCH

(Show at least four ties)

