SECTION

OF RANGE ADAMS COUNTY

COUNTY CORNER NO: 12 ROMPORTOL ID: 42006019020


PUBLIC LAND SURVEY MONUMENT RECORD

HARRISON TYPE OF MONUMENT: ADAMS COUNTY COORDINATES, NAD 83 (2007) N. 321278.318 E. 554353.691 - -- - DATUM_ -- -**ELEVATION-**12/21/2016 FIELD WORK DATE:


BASIS FOR MONUMENT LOCATION

1985 - PLS 1054 FOUND AN EXISTING HARRISION IN ADVANCE OF A HIGHWAY PROJECT. SET FOUR ALUMINUM CAP IRON PIPES FOR TIES.

2017 - PLS 2994 FOUND EXISTING HARRISON 24 INCHES BELOW THE ROAD SURFACE AND 4 EXISTING TIES. THE HARRISON AGREES WITH THE EXISTING TIES. ACCEPTED HARRISON AND REMEASURED TO THE 4 EXISTING TIES.

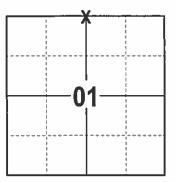

LOCATION (INDICATE CORNER BY "X")

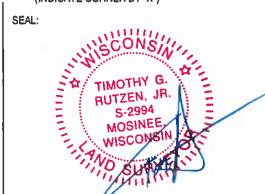

DATA SHOWN HERE ON THIS TIE SHEET IS CORRECT AND COMPLETE TO THE BEST OF MY KNOWLEDGE AND BELIEF.


PROFESSIONAL LAND SURVEYOR

- TIE SKETCH



 3/4" x 18" IRON REBAR SET, 1.50#/FT **⊕ ALUMINUM CAPPED BERNTSEN FOUND** HARRISON FOUND

VINYL "T" POST **→ EXISTING STEEL POST**

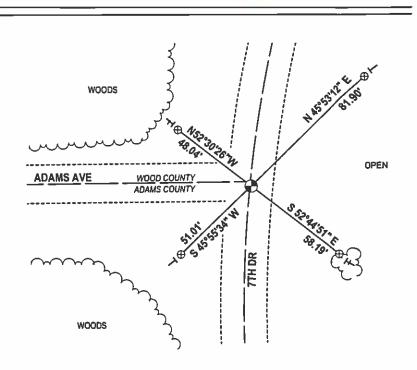


RECORD AND CERTIFICATION OF U.S. PUBLIC LAND SURVEY CONTROL STATION

Signature Registered Land Surveyor


E-D-716-72

District Project I. D. 4 6320-03-7/		Located by Dave Mozuch				
Corner N/4	SECTION	Township ZON	Range (E,W)	County		
Wisconsin Co-		East (X) 2,069,4	87.767	North (Y) 151 178,736	Elevation (Z)	Zone
Control Station	n Name	East (X) 2,07/,66	13.466	North (Y) 151, 191.985	Elevation (Z) /03と・とん	Zone
Horizontal —	NORTH A	MERICAN, 1927	CONTROL	_ DATUM	EVEL, 1929 ADJUSTME	NT
Horizontal E	us V S	d Order	SURVEY	CONTROL 3 rd	Order	

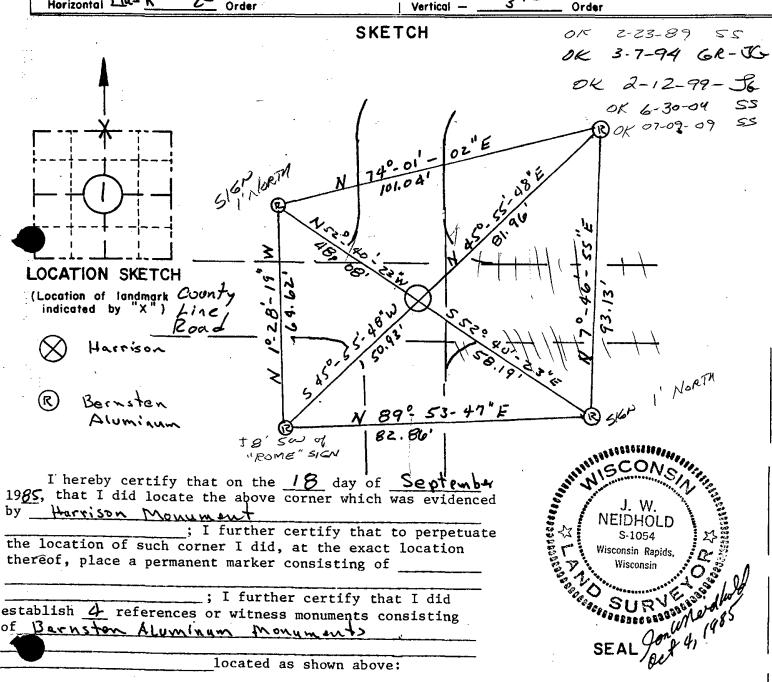

Registration No.

. •

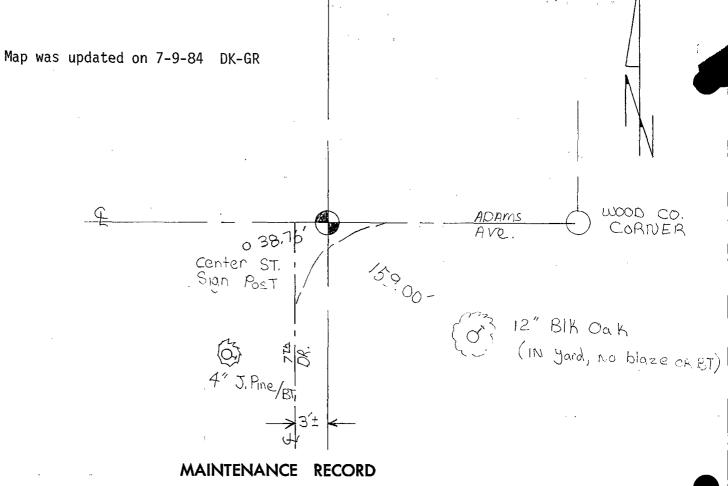

DATE	BY WHOM	REMARKS			
		<u> </u>			
· ·					
		,			
		\$			
Ì					
		·			

Government Land Corner Certificate	CORNER NO	12
ADAMS County	SECTION _	1
TYPE OF MONUMENT: HARRISON	TOWN _	20
STATE PLANE COORDINATES: N	RANGE	10
ELEVATION — M.S.L. DATUM:		
THETA ANGLE:	1	
FIELD BOOK: 86 PAGE 86		- 4
DRAWN BY: N.J.	<u> </u>	
	=	או
BASIS FOR MONUMENT LOCATION		·{
Show info such as: History of corner, with reference to Vol.	<u></u>	ا
and pg., dates, surveyor; exact description of monument replaced; if location computed, by taped or EDM traverse; landowner remarks, etc. (Use reverse side if necessary)	LOCATION (Indicated by 'X')	
landowner remarks, etc. (Use reverse side if necessary)	SEAL:	
No record of any resurveys. No evidence of any	ALL THE PROPERTY OF THE PARTY O	0 4.
previous monument could be found. This corner is	THING CONS	The state of the s
set equidistant between the NE and NW corners	Str. M.	(1 %)
of this section and on a line between the Siz	ANTHONY B.	* ***
and SE corners of section 36-21-6.	KIEDROWSKI S-878	M.
Entire intersection excavated with backhoe.	Wisconsin Rapids	. /23
Enotice in section executions as a	Wis.	105
See the reverse side of sheet for the up dated map	4.0	E AND THE REAL PROPERTY OF THE PERTY OF THE
of 7-9-84	View, SUR	Market
	DATA SHOWN HERE ON	
SEC MERCEDAVIS JUNES	CERTIFIED CORRECT:	0
P.O.T. 7105	Registered Land Gurveyor	eosk
	DATE: <u>1/5/81</u>	·····
TIE SKETCH		
Show at least four ties, also fence lines, roads, topo, size and type of witness trees' and if off road - best way to		
and type of witness trees and if off road - best way to arrive at corner.	.0.11	
arrive at corner.	E Parlor	
	\	
C ADAMS	AUE /	
4" JACKPINE &		
A" TACK		
*		
(3,		
∞ 1		