04 SECTION

O6 ADAMS COUNTY COUNTY CORNER NO: 26 ROMPORTOL ID: 42006040020

PUBLIC LAND SURVEY MONUMENT RECORD


HARRISON (BROKEN-TOP) TYPE OF MONUMENT:_ ADAMS COUNTY COORDINATES, NAD 83 (2007) N. 314049.672 E. 538536.103 ELEVATION- - - DATUM 05/02/2018 FIELD WORK DATE:_

BASIS FOR MONUMENT LOCATION


1974 - PLS 878 EXCAVATED WITH A BACKHOE AND FOUND THE BOTTOM 12" OF A VERY OLD 4" DIA. WOOD POST, WHICH APPEARS TO BE CEDAR. SET A HARRISON MONUMENT AT THE CORNER LOCATION AND TIED OUT.

1983 - PLS (UNKNOWN) SET 3 NEW TIES AT THE CORNER LOCATION.

2018 - PLS 2994 FOUND A HARRISON MONUMENT WITH A BROKEN-TOP 4" BELOW THE SURFACE, FOUND NO EVIDENCE OF ANY OF THE WITNESSES, ACCEPTED THE HARRISON MONUMENT WITH A BROKEN-TOP AS THE BEST EVIDENCE OF THE CORNER LOCATION. SET 4 NEW TIES AND MEASURED TO THE TIES.

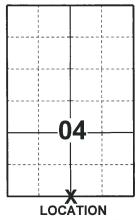

(INDICATE CORNER BY "X")

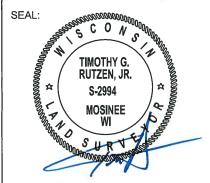


DATA SHOWN HERE ON THIS TIE SHEET IS CORRECT AND COMPLETE TO THE BEST OF MY KNOWLEDGE AND BELIEF.

PROFESSIONAL LAND SURVEYOR

7-18-18 DATE


- TIE SKETCH

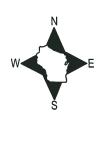

SET 3/4" x 18" IRON REBAR, 1.50#/FT

FOUND HARRISON MONUMENT (BROKEN-TOP)

VINYL "T" POST

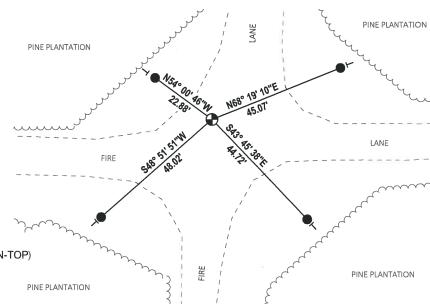

ADAMS COUNTY

Survey Monument Record

TYPE OF MONUMENT: Harrison standard STATE PLANE COORDINATES: N_ E

ELEVATION - M.S.L. DATUM: ___

THETA ANGLE: _

FIELD BOOK: ______ PAGE _


BASIS FOR MONUMENT LOCATION

(Use reverse side if necessary)


Show info such as: History of corner, with reference to Vol. and pg, dates, surveyor; exact description of monument replaced; if location computed, by taped or EDM traverse; landowner

Excavated with backhoe, found bottom 12" of very old 4" dia. wood post, appears to be cedar.


3 new ties set on 7-16-83 New map found on the reverse side of this sheet

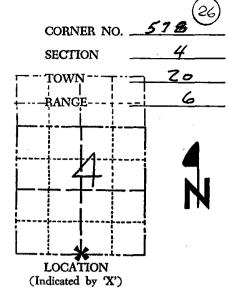


SEAL:

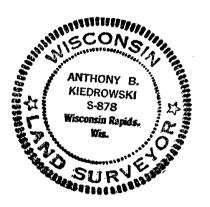

CERTIFIED CORRECT:

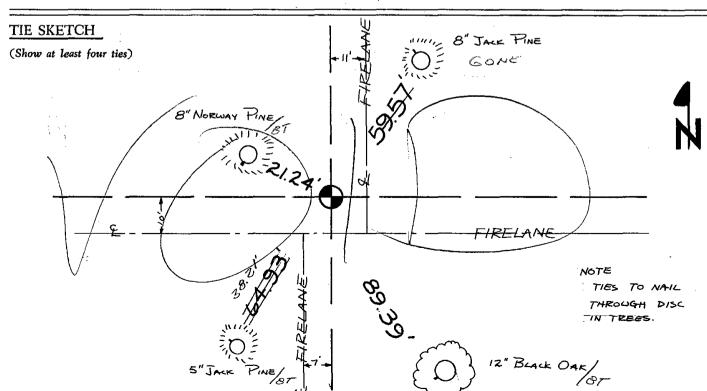

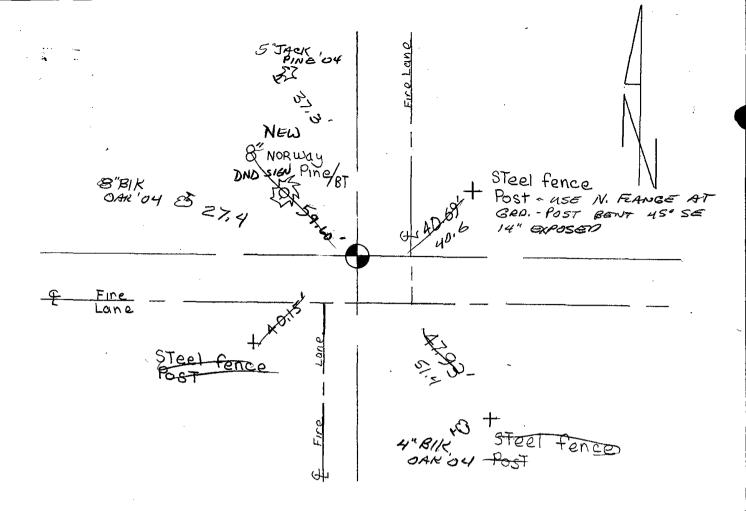

3 new ties 7-16-84 DK-MK

OK 2-23-57 SS

1-CONE, I-NEW 3-7-94 JG-GR

2-24-99-JG

6-30-04 ALL POSTS FD. DISTURBED - ALL NEW TIES SS

TOP OF MON, BROKEN - REMAINDER IN PLACE

TIES OK 3-13-09 SS