


Government Land Corner Certificate

Adams County
 TYPE OF MONUMENT: HARRISON
 STATE PLANE COORDINATES: N _____
 E _____
 ELEVATION — M.S.L. DATUM: _____
 THETA ANGLE: _____
 FIELD BOOK: LL. PAGE _____
 DRAWN BY: Basler

CORNER NO. 28
 SECTION 10
 TOWN 20
 RANGE 6E

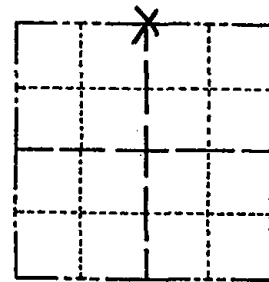

LOCATION
 (Indicated by 'X')

BASIS FOR MONUMENT LOCATION

Show info such as: History of corner, with reference to Vol. and pg., dates, surveyor; exact description of monument replaced; if location computed, by taped or EDM traverse; landowner remarks, etc. (Use reverse side if necessary)

Ran EDM traverse between NW Cor. 10-20-6E and NE Cor. 10-20-6E.
 Found iron rod at approximately the N $\frac{1}{4}$ Cor.
 Set N $\frac{1}{4}$ Cor. midway between said Section Corners, not on a straight line; used said found iron rod for line of North line NW $\frac{1}{4}$.

FOUND NOTHING 2-10-09 - CHECK SUBS FOR REFERENCE?


Ok 6-28-84 MK-SS

CORNER SEEMS TO BE UNDER WOODEN SHED BEHIND HOUSE NO. 142 ONLY ONE TIE LEFT.

2-17-99-JG

2-26-04 NOTHINGS CHANGED, -JG

SEAL:

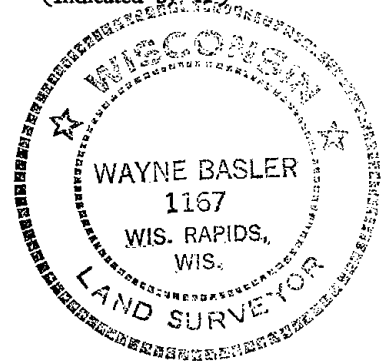

DATA SHOWN HERE ON CERTIFIED CORRECT:

Wayne Basler
 Registered Land Surveyor

DATE: 4-17-80

TIE SKETCH

Show at least four ties, also fence lines, roads, topo, size and type of witness trees and if off road - best way to arrive at corner.

