03 SECTION

ADAMS COUNTY COUNTY CORNER NO: 29

ROMPORTOL ID: 42006030000


PUBLIC LAND SURVEY MONUMENT RECORD

HARRISON (BROKEN-TOP) TYPE OF MONUMENT: ADAMS COUNTY COORDINATES, NAD 83 (2007) N. 314180.962 E. 546430.560 ELEVATION- - - -DATUM 05/01/2018 FIELD WORK DATE:


BASIS FOR MONUMENT LOCATION

1980 - PLS 1167 FOUND A 1/2 x24" SOLID IRON ROD. IT WAS ASSUMED TO HAVE BEEN SET BY SURVEYORS DURING WORK OF THE WALDEN PINES ADDITION SUBDIVISION. RAN EDM TRAVERSE AROUND THE NORTH LINE OF 10-20-6E TO VERIFY. ACCEPTED THE IRON ROD AS THE CORNER LOCATION. REPLACED THE ROD WITH A HARRISON MONUMENT AND TIED OUT.

2018 - PLS 2994 FOUND A HARRISON MONUMENT WITH A BROKEN-TOP 8" BELOW THE ROAD SURFACE. FOUND NO EVIDENCE OF ANY OF THE WITNESSES. ACCEPTED THE HARRISON MONUMENT WITH A BROKEN-TOP AS THE BEST EVIDENCE OF THE CORNER LOCATION. SET 4 NEW TIES AND MEASURED TO THE TIES.

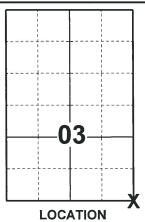

(INDICATE CORNER BY "X")

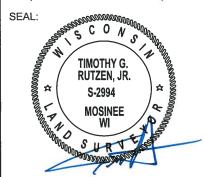


DATA SHOWN HERE ON THIS TIE SHEET IS CORRECT AND COMPLETE TO THE BEST OF MY KNOWLEDGE AND BELIEF.

PROFESSIONAL LAND SURVEYOR

7-18-18

-TIE SKETCH

NOTE: THE CORNER FALLS 2'± WEST OF THE CENTERLINE OF 9TH AVE AND 24'± SOUTH OF THE CENTERLINE OF WALDEN OAKS WAY.

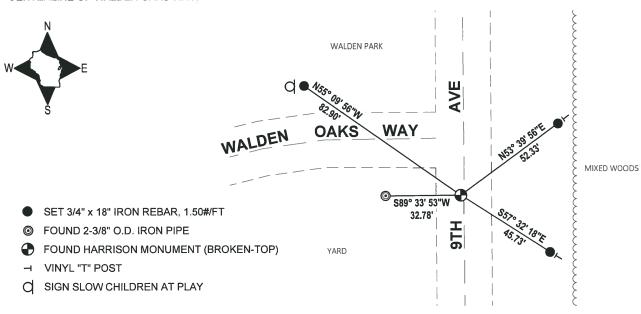

Government Land Corner Certificate	`	
A face Country	CORNER NO	
TYPE OF MONUMENT: HARRISON	SECTION	
STATE PLANE COORDINATES: N	TOWN	20
<u> </u>	RANGE	_GE
ELEVATION — M.S.L. DATUM:		X
THETA ANGLE:		
PAGE DRAWN BY: BAS PAGE		.
		-
BASIS FOR MONUMENT LOCATION		
Show info such as: History of corner, with reference to Vol.		i
and pg., dates, surveyor; exact description of monument	LOCATION	~ ~
landowner remarks, etc. (Use reverse side if necessary)	SEAL: (Indicated by 'X	')
	4660836830	220p.
Found 1 x24" solid iron rod, assumed to have been	SEAL:	1074 C
set by Surveyors during work of WALDEN PINES ADD. Ran EDM traverse arounr North Line 10-20-6E.	A. A	
Accepted said rod as correct and replaced with		
Harrison Monument.	WAYNE BA	SLER DS CONTROL OF THE PROPERTY OF THE PROPERT
OK 7-9-84 GR-DK	WIS RAP	DS.
0K7-23-89 55	WIS.	A B TO BE SEE SEE SEE SEE
2- NEW TIE 3-7-94 JG-6R	NO SUR	VE TERBER
1-GONE, 4 LEFT 2-17-99- JG	· · · · · · · · · · · · · · · · · · ·	E E E E
OK, 2-24-04-JG OK 07-09-09 55	DATA SHOWN HERE O	N
0K 0/257-01 55	CERTIFIED CORRECT:	. /
	Registered Land Surveyor	ill-
	DATE: 4-17-8	30
TIE SKETCH		
Show at least four ties, also fence lines, roads, topo, size	a Spk. in Power	Pole
and type of witness trees' and if off road - best way to CONE 99" arrive at corner.		
6 TH PARK		
Region of the second		
Walden Queens W		
Way	SPK. IZ"	5. Pine
53.39	Dead N	S. PINE AIL STILL GOOD
49.950		_
24.48		
Spk. Power Pole		
1 1		
₹ E	_	
0	-	
		Dala
	€ SPK. m Po	WEN FOIL

MAINTENANCE RECORD

DATE	BY WHOM	REMARKS
		
-		
\		
ļ		