

## PUBLIC LAND SURVEY MONUMENT RECORD

TYPE OF MONUMENT: HARRISON  
 ADAMS COUNTY COORDINATES, NAD 83 (2007)

N. 314165.340

E. 554404.762


ELEVATION- - - - - DATUM - - - - -

FIELD WORK DATE: 05/01/2018

### BASIS FOR MONUMENT LOCATION


1981 - PLS 878 NO RECORD OF ANY RESURVEYS. FOUND NO EVIDENCE OF THE ORIGINAL OR SUBSEQUENT MONUMENT. CALCULATED THE CORNER LOCATION ON A STRAIGHT LINE AND EQUIDISTANT BETWEEN SECTION CORNERS. COULD NOT JUSTIFY AN ANGLE POINT. IT WOULD HAVE PUT THE CORNER INTO THE FENCE CORNER. SET HARRISON AND TIED OUT.

2018 - PLS 2994 FOUND A HARRISON MONUMENT 4" ABOVE THE GROUND SURFACE. FOUND NO EVIDENCE OF ANY OF THE TIES OR WITNESSES. ACCEPTED THE HARRISON MONUMENT AS THE BEST EVIDENCE OF THE CORNER LOCATION. SET 4 NEW TIES AND MEASURED TO THE TIES.

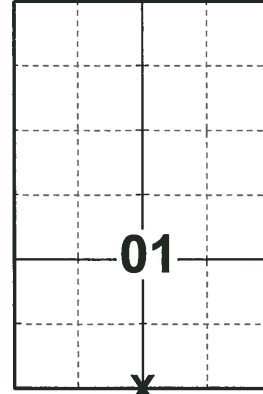

**LOCATION**  
 (INDICATE CORNER BY "X")

SEAL:

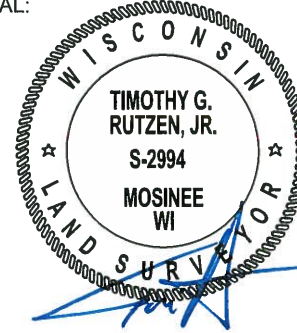


DATA SHOWN HERE ON THIS TIE SHEET IS CORRECT AND COMPLETE TO THE BEST OF MY KNOWLEDGE AND BELIEF.

PROFESSIONAL LAND SURVEYOR

DATE 7-18-18

### - TIE SKETCH -

NOTE: THE CORNER FALLS 200± EAST OF THE EXISTING TRAIL.

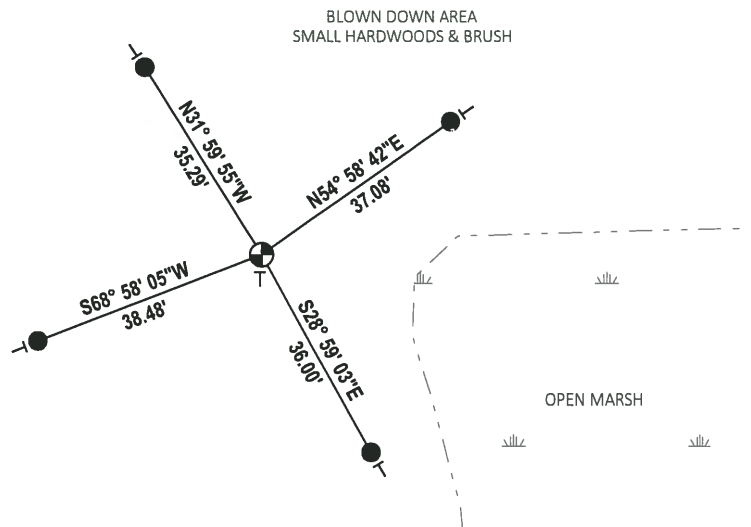


- SET 3/4" x 18" IRON REBAR, 1.50#/FT
- ⊕ FOUND HARRISON MONUMENT
- | VINYL "T" POST

# Government Land Corner Certificate

ADAMS County  
 TYPE OF MONUMENT: HARRISON  
 STATE PLANE COORDINATES: N \_\_\_\_\_  
 E \_\_\_\_\_  
 ELEVATION — M.S.L. DATUM: \_\_\_\_\_  
 THETA ANGLE: \_\_\_\_\_  
 FIELD BOOK: 86 PAGE 84  
 DRAWN BY: N. J.

CORNER NO. 32  
 SECTION 1  
 TOWN 20  
 RANGE 6

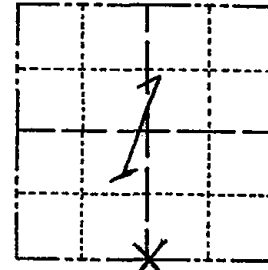

LOCATION  
 (Indicated by 'X')


## BASIS FOR MONUMENT LOCATION

Show info such as: History of corner, with reference to Vol. and pg., dates, surveyor; exact description of monument replaced; if location computed, by taped or EDM traverse; landowner remarks, etc. (Use reverse side if necessary)

No record of any resurveys. Could find no evidence of the original or subsequent monument. This corner set on a straight line and equidistant between section corners. Could not justify a P.I. that would have put the corner into the fence corner.

Ok 5-10-84 DK-SS  
 OK 2-23-89 SS  
 OK 3-31-94 JG-SS  
 1 NEW TIE 3-1-99 JG-SS  
 OR BUT AREA UNDERWATER 6-30-04  
 1-7-10 SS 1 NEW TIE

SEAL:

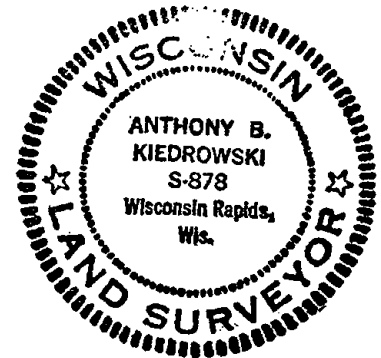

DATA SHOWN HERE ON  
 CERTIFIED CORRECT:

*Anthony B. Kiedrowski*  
 Registered Land Surveyor

DATE: 1/5/81

## TIE SKETCH

Show at least four ties, also fence lines, roads, topo, size and type of witness trees and if off road - best way to arrive at corner.

