## PUBLIC LAND SURVEY MONUMENT RECORD

**RAILROAD SPIKE** TYPE OF MONUMENT:\_ ADAMS COUNTY COORDINATES, NAD 83 (2007) N. 311354.307 E. 530597.308 ELEVATION- - - -DATUM 05/03/2018 FIELD WORK DATE:

## BASIS FOR MONUMENT LOCATION


1974 - PLS 841 FOUND NO ORIGINAL OR RECORD CORNER EVIDENCE. CALCULATED THE CORNER LOCATION BY PROPORTIONAL MEASUREMENT. EXCAVATED THE AREA WITH A BACKHOE. SET A STANDARD 30" C.I. HARRISON MONUMENT AT THE CORNER 6"± BELOW GRADE AND TIED OUT.

1995 - PLS (UNKNOWN) REMOVED MONUMENT FOR ROAD CONSTRUCTION AND REPLACED IT WITH A RAILROAD SPIKE AND RE-TIED THE CORNER.

2018 - PLS 2994 FOUND A RAILROAD SPIKE FLUSH WITH THE ROAD SURFACE AND 1 WITNESS TREE. REMOVED THE RAILROAD SPIKE AND EXCAVATED BELOW AND FOUND NO EVIDENCE OF ANY OTHER MONUMENTATION. THE RR SPIKE AGREES WITH THE EXISTING WITNESS TREE. ACCEPTED THE RAILROAD SPIKE AS THE CORNER LOCATION. SET 4 NEW TIES AND MEASURED TO THE TIES AND WITNESS TREE.

PINE PLANTATION

PINE PLANTATION

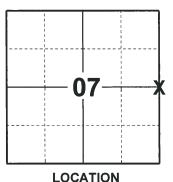

(INDICATE CORNER BY "X")

SEAL: TIMOTHY G. RUTZEN, JR. S-2994 MOSINEE SUR

DATA SHOWN HERE ON THIS TIE SHEET IS CORRECT AND COMPLETE TO THE BEST OF MY KNOWLEDGE AND BELIEF.

PINE PLANTATION

PINE PLANTATION

PROFESSIONAL LAND SURVEYOR

7-18-18 DATE

## -TIE SKETCH

NOTE: THE CORNER FALLS 0.5' WEST OF THE CENTERLINE OF 13TH AVE AND 30'± SOUTH OF THE CENTERLINE OF ALPINE DR (CTH D).




CTH D **ALPINE DR** 

- SET 3/4" x 18" IRON REBAR, 1.50#/FT
- FOUND RAILROAD SPIKE
- VINYL "T" POST
- WITNESS TREE

Government Land Corner Certificate		(3
	CORNER NO	618
County	SECTION	_ 8
TYPE OF MONUMENT: RAIL ROAD SPIKE STATE PLANE COORDINATES: N	TOWN	20 N
STATE PLANE COORDINATES: NE	RANGE	6E
ELEVATION — M.S.L. DATUM:		
THETA ANGLE:		1
FIELD BOOK: PAGE		
DRAWN BY:	<u> </u>	
DAGG FOR A COMMAND		N
BASIS FOR MONUMENT LOCATION		
Show info such as: History of corner, with reference to Vol. and pg., dates, surveyor; exact description of monument		J
replaced; if location computed, by taped or EDM traverse; landowner remarks, etc. (Use reverse side if necessary)	LOCATION	
MONUMENT REMOVED FOR ROAD CONSTRUC	SEAL: (Indicated by 'X')	
RAILROAD SPIKE SET - NEW DISTANCES		
8-14-95 SS- JG	>	
2 11 13 33-3G		
	İ	
•	i	
		•
1-GONE, 3-LEFT 1-11-99 JG-5F "	DATA SHOWN HERE ON CERTIFIED CORRECT:	
SEE BACK OF PAGE 2		
SCO BACK OF PAGE &	Registered Land Surveyor	<del></del>
	DATE:	·
The overest 's		
TIE SKETCH	×.	
Show at least four ties, also fence lines, roads, topo, size and type of witness trees' and if off road - best way to		, 11
arrive at corner.	Four Sto	J. PINE
	Fence X	×
·		
<i>Q</i>	C.T. H. " D"	
	No Mp	***************************************
	6. 43. B	
31.40′	9 //-	
· · · · · · · · · · · · · · · · · · ·		
	4.5	<del></del>
1 568 36.62°	65.88 I	
DND SIGN -	D SALL D	
& METAL POST 5 J. PINE	FOWER PO	FE
NEXT TO BY		
'		

AT ATEC COTTO	corner no. 6/8 <sup>(35)</sup>
ADAMS COUNTY	_
Survey Monument Record	SECTION 8
TYPE OF MONUMENT: HARRISISON STANDARD	/- ·
STATE PLANE COORDINATES: N	RANGE <u>GE</u>
ELEVATION — M.S.L. DATUM:	
THETA ANGLE: PAGE	4
FIELD BOOK: PAGE	*+++-  NI
	1
BASIS FOR MONUMENT LOCATION	
(Use reverse side if necessary)	LOCATION
Show info such as: History of corner, with reference to Vol. and pg, dates, surveyor; exact description of monument replaced; if location computed, by taped or EDM traverse; landowner remarks, etc.	(Indicated by 'X') SEAL:
NO ORIGINAL OR RECORD CORNER	- 197111111111111
EVIDENCE FOUND. CORNER	SERVING CONSTANT
SET BY PROPORTIONAL	WILLIAM C.
MEASUREMENT, BASED	ROHDE
ON EDM TRAVERSE OF	WILLIAM C. ROHDE S-0841 Wisconsin Rapids, Wisconsin
SECTION. STD 30"C.I.	WILLIAM C. ROHDE S-0841 Wisconsin Rapids, Wisconsin
HARRISON MONUMENT DO	SUR SUR
SET @ CORNER WITH	1
<b>J</b>	CERTIFIED CORRECT:
W. V	alline Tolle
	Registered Land Surveyor  DATE: 10 30 74
TIE SKETCH W	CALM
(Show at least four ties)	OVERCAST
T Z IN FENCE COR	<b>∠</b>
PK NAIL/DISC.	, 7
	AIL/DISC
GRINE / 503	PACK PINE
No E	ence /
1 1 1 1 1 1 1 1 1 1 1 1 1 1 1 1 1 1 1	
The state of the s	THO PAVENIENT
30.4	
- Y SEC	TION LINE
STRISING NO. 10.3 See the r	MON.O.K. 6-7-79 RN-RW
	reverse side for the updated 7-84
STEEL POST Z PENALLE	
SET SW OF I	
CORNER.	NOT TO SCALE
REVISED 1974	

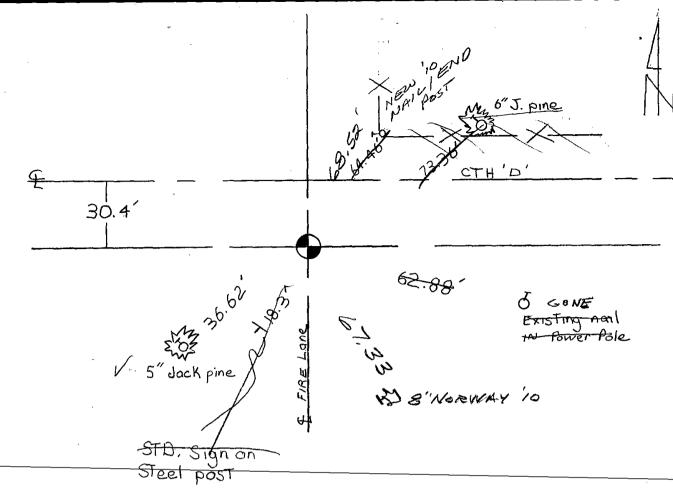

Map updated on 5-7-84 SS-DK

OK 3-7-94 - JG-Ge

1-GONE, 2-25-04-56 NOTE: USE TIES -MON.

FORR SAIKE 1-11-10

REMOVED CONSTRUCTION.

Z NEW TIES 55

6-12-85