PUBLIC LAND SURVEY MONUMENT RECORD

HARRISON TYPE OF MONUMENT: ADAMS COUNTY COORDINATES, NAD 83 (2007) N. 311464.157 E. 541163.271


ELEVATION- - - DATUM

FIELD WORK DATE:

BASIS FOR MONUMENT LOCATION

1979 - PLS 878 EXCAVATED THE AREA WITH A BACKHOE AND FOUND NO EVIDENCE OF THE CORNER. THE CORNER WAS CALCULATED USING THE TIE DISTANCE TO THE WELLINGTON ADDITION TO LAKE CAMELOT. THIS ALSO AGREES WITH THE OLD DEED DIMENSIONS TO THE SPRING VALLEY CEMETERY TO THE NORTH. ALSO DUG WITH A BACKHOE FOR THE STONE CALLED FOR AT THE NORTHWEST CORNER OF THE CEMETERY AND FOUND NOTHING THERE. SET HARRISON AND TIED OUT.

2018 - PLS 2994 FOUND A HARRISON MONUMENT, 4 TIES AND 1 PROPERTY IRON. THE MONUMENT AGREES WITH THE EXISTING TIES. ACCEPTED THE HARRISON MONUMENT AS THE CORNER LOCATION. MEASURED TO THE TIES AND PROPERTY

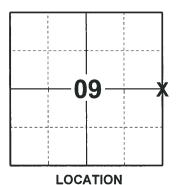

(INDICATE CORNER BY "X")



DATA SHOWN HERE ON THIS TIE SHEET IS CORRECT AND COMPLETE TO THE BEST OF MY KNOWLEDGE AND BELIEF.


PROFESSIONAL LAND SURVEYOR

7-18-18 DATE_

-TIE SKETCH

NOTE: THE CORNER FALLS 1'± SOUTH OF THE WOODEN FENCE.



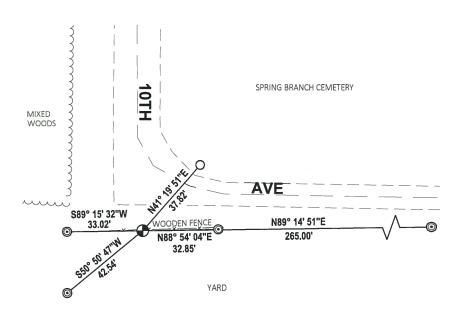

- SET 3/4" x 18" IRON REBAR, 1.50#/FT
- O FOUND 3/4" IRON ROD
- FOUND 2-3/8" O.D. IRON PIPE
- FOUND HARRISON MONUMENT

BASIS_FOR MONUMENT LOCATION

Show info such as: History of corner, with reference to Vol. and pg., dates, surveyor; exact description of monument replaced; if location computed, by taped or EDM traverse; landowner remarks, etc. (Use reverse side if necessary)

Excavated area with backhoe. Found nothing. Corner was set according to tie to Wellington Addition to Lake Camelot. This also matches old deed dimensions to the Spring Valley Cemetary north of here. I also dug with a backhoe for the stone called for at the northwest corner of the cemetary, and found nothing there.


OK 4-23-84 SS-DK

OK 3-101/94 GR55


OK 2-17-99-JG

OK 2-24-84-JG

OK 2-10-09 SS

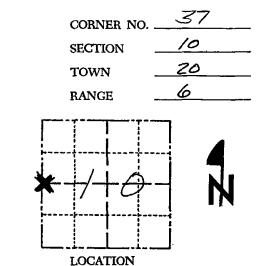

SEAL:

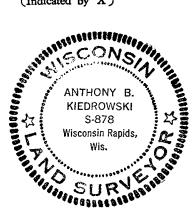

(Indicated by 'X')


DATA SHOWN HERE ON CERTIFIED CORRECT:

Registered Land Surveyor

DATE: 12/5/79

TIE SKETCH

Show at least four ties, also fence lines, roads, topo, size and type of witness trees' and if off road - best way to arrive at corner.

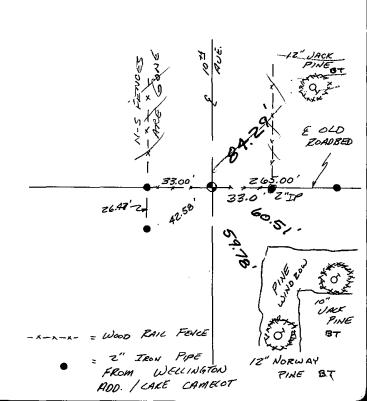

MAINTENANCE RECORD

DATE	BY WHOM	REMARKS