06 RANGE ADAMS COUNTY CORNER NO: 57 ROMPORTOL ID: 42006162000


PUBLIC LAND SURVEY MONUMENT RECORD

HARRISON TYPE OF MONUMENT: ADAMS COUNTY COORDINATES, NAD 83 (2007) N. 306157.379 E. 541205.116 ELEVATION- - - DATUM 05/09/2018 FIELD WORK DATE:


BASIS FOR MONUMENT LOCATION

1981 - PLS 1167 CALCULATED CORNER FROM INFORMATION SUPPLIED FROM RLS #699, AND DATA SHOWN ON INVERNESS ADDITION TO LAKE CAMELOT. THIS METHOD FIT THE AREA OF POSSESSION. SET HARRISON AND TIED OUT.

2018 - PLS 2994 FOUND A HARRISON MONUMENT 1" BELOW THE ROAD SURFACE,1 TIE AND 2 PROPERTY IRONS. THE MONUMENT AGREES WITH THE EXISTING TIE. ACCEPTED THE HARRISON MONUMENT AS THE CORNER LOCATION. SET 1 NEW TIE AND MEASURED TO THE TIES.

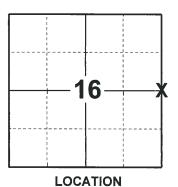

(INDICATE CORNER BY "X")

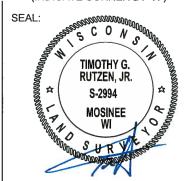

DATA SHOWN HERE ON THIS TIE SHEET IS CORRECT AND COMPLETE TO THE BEST OF MY KNOWLEDGE AND BELIEF.

PROFESSIONAL LAND SURVEYOR


7-18-18 DATE

-TIE SKETCH

NOTE: THE CORNER FALLS 7'± EAST OF THE CENTERLINE OF FOSSE CT/10TH AVE.



- SET 3/4" x 18" IRON REBAR, 1.50#/FT
- FOUND 1-1/4" IRON ROD
- FOUND 2-3/8" O.D. IRON PIPE
- FOUND HARRISON MONUMENT
- STEEL FENCE POST

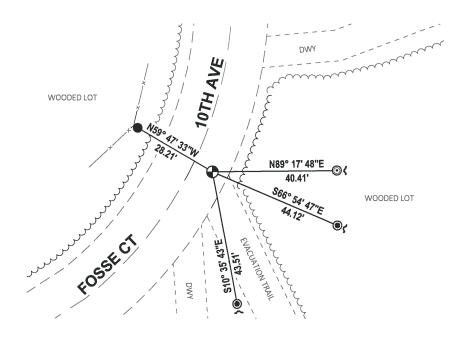

Government Land Corner Certificate	
A 1.	CORNER NO. 57
TYPE OF MONUMENT: HARRISON	SECTION 16
STATE PLANE COORDINATES: N	TOWN20
E	range 6E
ELEVATION — M.S.L. DATUM:	[ii
THETA ANGLE:	
DRAWN BY: Boslex	
	++++ N
BASIS FOR MONUMENT LOCATION	
Show info such as: History of corner, with reference to Vol.	
and pg., dates, surveyor; exact description of monument replaced; if location computed, by taped or EDM traverse; landowner remarks, etc. (Use reverse side if necessary)	LOCATION
landowner remarks, etc. (Use reverse side if necessary) SEA	(Indicated by 'X') L:
	The state of the s
Set corner from information supplied from RIS #699, and data shown on Inverness Add. to	
Lake Camalot.	
This method fits the area and possession.	WAYNE BASLER
7-16-84 DK-MK	1167 ₹ £
1 NOW THE 5-17-89 55	WIS. RAPIDS,
av 31 Mad Class	WIS. RAPIDS, WIS.
7 Nov. 3 + 20 8-3/194 55	
OK 3/01/94 GL-55 2 NOW THES 8-31-09 55 4 TIES REMAIN 2-10-09, 55	TA SHOWN HERE ON
CE	RTIFIED CORRECT:
· .	Sayn Bable
_	ristered Land Surveyor TE:Nov 1981
DA	TE: //0/. //0/
TIE SKETCH	157 8"J. PINE /NAIL 3' ABUNE (MAS) EROUND
Show at least four ties, also fence lines, roads, topo, size	NAIL Power Pole
and type of witness trees' and if off road - best way to arrive at corner.	b /
Ex. 1" Solid Rod By	
6"J.P. FO. DIST, 6 5	
47 20 00 10 100	
NAH power pole	
	•
40.52	Ex. 2" Iron pipe
TH' WEST	
EAST EN BLACKTOF	OCE OF O IN CURVE
Vi A & &	
60536 (10)	
1/20h	
7" J. Rine	
NA, 1 & Blaze	

MAINTENANCE RECORD

DATE	BY WHOM	REMARKS
	 	
<u></u>		
	<u> </u>	