

PUBLIC LAND SURVEY MONUMENT RECORD

TYPE OF MONUMENT: HARRISON
ADAMS COUNTY COORDINATES, NAD 83 (2007)

N. 306258.672

E. 551759.613


ELEVATION- DATUM

FIELD WORK DATE: 05/07/2018

BASIS FOR MONUMENT LOCATION

1978 - PLS 878 EXCAVATED AT THE CORNER LOCATION AND FOUND NO EVIDENCE OF THE CORNER. NO RECORDS OF OLD RESURVEYS EXIST. CALCULATED THE CORNER FROM ADAMS COUNTY CONCRETE REFERENCE MONUMENTS AND SET A HARRISON AND TIED OUT.

2018 - PLS 2994 FOUND A HARRISON MONUMENT 18" BELOW THE ROAD SURFACE. FOUND NO EVIDENCE OF ANY OF THE WITNESSES. ACCEPTED THE HARRISON MONUMENT AS THE BEST EVIDENCE OF THE CORNER LOCATION. SET 4 NEW TIES AND MEASURED TO THE TIES.

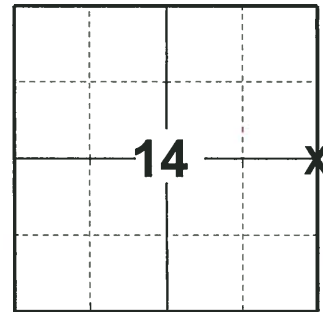

LOCATION
(INDICATE CORNER BY "X")

SEAL:





DATA SHOWN HERE ON THIS TIE SHEET IS CORRECT AND COMPLETE TO THE BEST OF MY KNOWLEDGE AND BELIEF.

PROFESSIONAL LAND SURVEYOR

DATE 7-18-18

TIE SKETCH

NOTE: THE CORNER FALLS 5'± WEST OF THE CENTERLINE OF 8TH AVE.

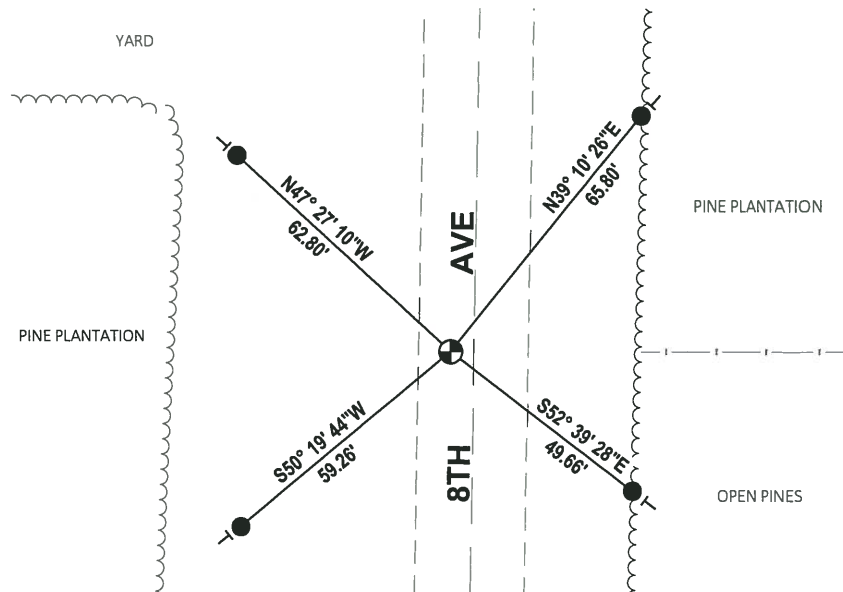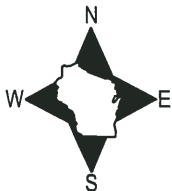


- SET 3/4" x 18" IRON REBAR, 1.50#/FT
- ⊕ FOUND HARRISON MONUMENT
- VINYL "T" POST

Government Land Corner Certificate

ADAMS County
 TYPE OF MONUMENT: HARRISON MONUMENT
 STATE PLANE COORDINATES: N _____
 E _____
 ELEVATION — M.S.L. DATUM: _____
 THETA ANGLE: _____
 FIELD BOOK: 64 PAGE 17
 DRAWN BY: BETTY MERZ

CORNER NO. 76
 SECTION 14
 TOWN 20
 RANGE 6

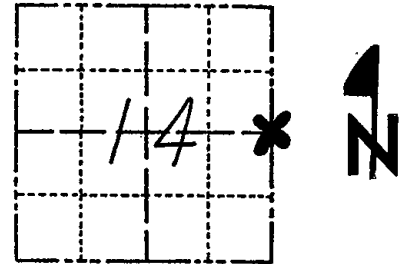

LOCATION
(Indicated by 'X')

BASIS FOR MONUMENT LOCATION

Show info such as: History of corner, with reference to Vol. and pg., dates, surveyor; exact description of monument replaced; if location computed, by taped or EDM traverse; landowner remarks, etc. (Use reverse side if necessary)

Excavated with backhoe. Found Nothing.
 No records of old resurveys. Corner set from
 Adams County concrete reference monuments.

OK 7-13-79 RN RW

Ok 4-19-84 DJK

SEAL:




DATA SHOWN HERE ON
 CERTIFIED CORRECT:

Anthony B. Kiedrowski
 Registered Land Surveyor

DATE: 2/2/28

TIE SKETCH

Show at least four ties, also fence lines, roads, topo, size and type of witness trees' and if off road - best way to arrive at corner.

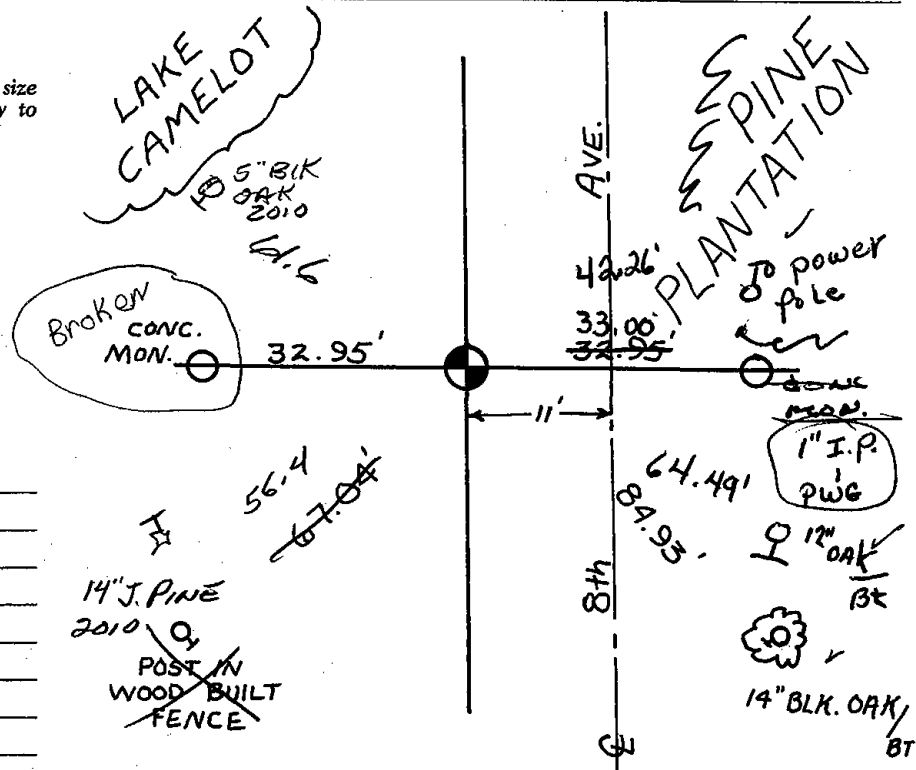

MAINTENANCE RECORD

Date	Init.	Remarks
3/23/79	Rm/ow	o.k.
3-8-89	GR-SS	OK
3-31-94	JG-SS	"
1-11-99	JG-SF	OK
2-24-04	JG	OK
1-7-10	SS	2 NEW