ADAMS COUNTY

COUNTY CORNER NO: 60

ROMPORTOL ID: 42006132000

PUBLIC LAND SURVEY MONUMENT RECORD

TYPE OF MONUMENT: HARRISON

ADAMS COUNTY COORDINATES, NAD 83 (2007)

N. 306238.130

E. 557071.368

ELEVATION- — DATUM — — —


FIELD WORK DATE: 02/06/2018

BASIS FOR MONUMENT LOCATION


1979 - PLS 1478 CALCULATED THE CORNER BY PROPORTIONATE MEASUREMENT AND ON THE RANGE LINE BETWEEN THE NE CORNER OF SECTION 13-20-6 AND THE SE CORNER 25-20-6. NO RECORD OF ANY PREVIOUS REMONUMENTATION WAS FOUND. NO EVIDENCE OF ANY PREVIOUS MONUMENTATION WAS FOUND. SET A HARRISON MONUMENT AND TIED OUT.

1984 - PLS UNKNOWN UPDATED THE TIESHEET AND ADDED 2 NEW TIES.

2018 - PLS 2994 FOUND A HARRISON MONUMENT FLUSH WITH THE GROUND SURFACE AND 3 WITNESS TREES. THE MONUMENT AGREES WITH THE EXISTING WITNESS TREES. ACCEPTED THE HARRISON MONUMENT AS THE CORNER LOCATION. SET 4 NEW TIES AND MEASURED TO THE TIES AND WITNESS TREES.

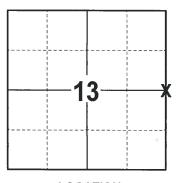

LOCATION (INDICATE CORNER BY "X")

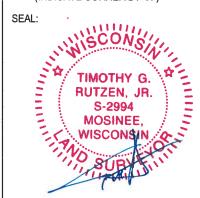

DATA SHOWN HERE ON THIS TIE SHEET IS CORRECT AND COMPLETE TO THE BEST OF MY KNOWLEDGE AND BELIEF.

PROFESSIONAL LAND SURVEYOR


DATE 3-1-18

- TIE SKETCH

NOTE: THE CORNER FALLS 30'± SOUTHEASTERLY OF THE CENTERLINE OF THE TRAIL.



● 3/4" x 18" IRON REBAR SET, 1.50#/FT ● HARRISON FOUND → VINYL "T" POST → FOUND WITNESS TREE

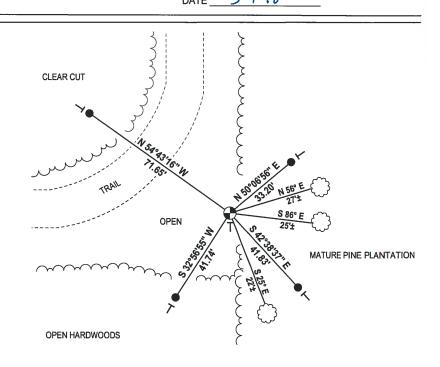

Government Land Corner Certificate

ADAMS		County	
TYPE OF MONUMENT:			
STATE PLANE COORDINA	ATES: N		
	E		
ELEVATION — M.S.L. D	ATUM:	·	
THETA ANGLE:			
FIELD BOOK: 76	<u> </u>	_ PAGE	·
DRAWN BY: _ROGER	NUBET	₹	

-++*

CORNER NO.

20

SECTION

TOWN RANGE

LOCATION
(Indicated by 'X')


BASIS FOR MONUMENT LOCATION

Show info such as: History of corner, with reference to Vol. and pg., dates, surveyor; exact description of monument replaced; if location computed, by taped or EDM traverse; landowner remarks, etc. (Use reverse side if necessary)

Set Corner proportionate and on the range line between the NE Cor. of Section 13-20-6 and the SE Cor. 25-20-6. No record of any previous remonumentation was found.

No evidence of any previous monumentation was found.


See the reverse side for the updated map 6-28-84

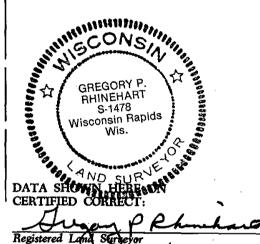


DATE:

TIE SKETCH

Show at least four ties, also fence lines, roads, topo, size and type of witness trees' and if off road - best way to arrive at corner.

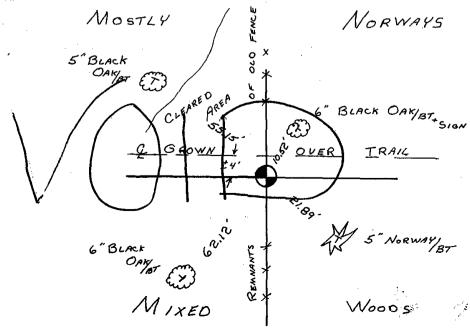

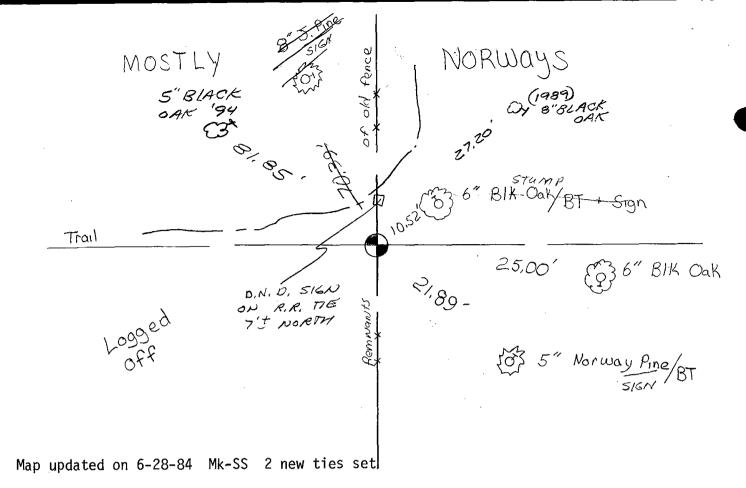

MAINTENANCE RECORD

DATE	BY WHOM	REMARKS		
5-17-89	S2:	1 NEW 71E		
4-24-94	TG- 55	/ NEW TIE		
5-17-89 4-24-94 3-5-99	JG	6K		
\ <u></u>				
dr.				
	<u> </u>			