Government Land Corner Certificate

ADAMS	_County		
TYPE OF MONUMENT: Harrison	Conument 1/2 x60" IRON PIPE		
STATE PLANE COORDINATES: N			
ELEVATION — M.S.L. DATUM:			
FIELD BOOK: 76 DRAWN BY: ROCKR NUBER			


CORNER NO. SECTION /3 TOWN 20 RANGE 6

BASIS FOR MONUMENT LOCATION

Show info such as: History of corner, with reference to Vol. and pg., dates, surveyor; exact description of monument replaced; if location computed, by taped or EDM traverse; landowner remarks, etc. (Use reverse side if necessary)

Set Monument single proportionate and on range line between the NE Cor. 13-20-6 and the SE Cor. 25-20-6. No record of any remonumentation of the original corner was found. No evidence of either the original monument nor any remonumentation was found.

OK 4-27-84 SS-DK

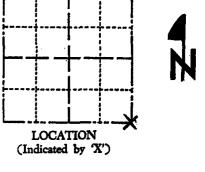

GREGORY P.
RHINEHART
S-1478
Wisconsin Rapids
Wis.


DATA SHOWN HERE ON
CERTIFIED CORRECT:

DATE: 6/4/79

SEAL:

TIE SKETCH

Show at least four ties, also fence lines, roads, topo, size and type of witness trees' and if off road - best way to arrive at corner.

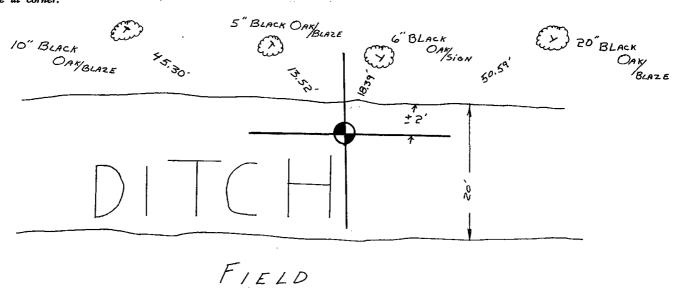

MAINTENANCE RECORD

DATE	BY WHOM	REMARKS
13 JUNE 94	14-CR ,	DK_
i	1	· · · · · · · · · · · · · · · · · · ·